


KANSAS

Stafford

Section 36 Township 23 Range 11W

Well No. #2 Volker

Company Transwestern

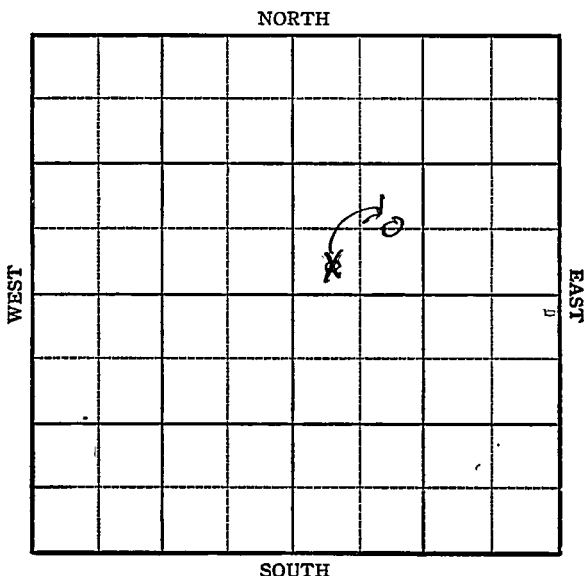

KANSAS

Sec. 36 Twp. 23 R. 11W

Well No. #2 Volker Farm

Transwestern Company

Zenith

Ft. from N. Line

660
330

Ft. from S. Line


Ft. from E. Line

990
450

Ft. from W. Line

SW NE

less. +80+1802 SOUTH

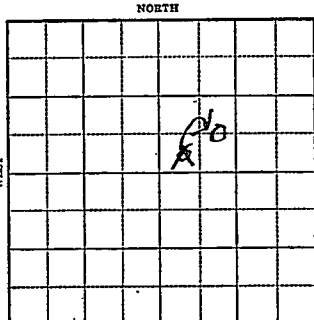

1944

R E P O R T

2/9

Location

2/15

Rotary

2/23

"

3/1

Surface hole

3/8

9" @ 295
Drilling 2310'

3/16

Drilling 3400

#/22

Lans 3305
Misener 3665
Viola 3683 SQ
TD 3703
5" @ 3702
Rust

3/29

"

4/5

"

4/12

TD 3713-HFO in 1 hr
1000 acid flow 1.2 oil in 3 hrs.

OVER

1944

4/19

5" @ 3702

Viola 3683

T^U 3713

1000 acid

Bomb Pot 4039

Max 3000

Gravity 42

COMPLETED

KANSAS

Map No. 47 Sec. 36 Twp. 23 R. 11WWell No. 2 Volker

Transwestern

Company

FIRST REPORT

Contractor

SW NE

SECTION FLAT

		o	

Ft. from N. Line

330

Ft. from S. Line

Ft. from E. Line

450

Ft. from W. Line

Zenith Pool

Location X

Rig up

Drilling and Remarks:

RECORD

Cased _____ in., _____ ft.

Sand _____

Gas _____

Oil _____

Total Depth _____

PRODUCTION

1st 24 hrs. Nat. _____

1st 24 hrs. after shot _____

Gas _____ Cu. Ft.

Dry Hole _____

Abandoned _____

Date

FEB 9 1944 19

S. J. LEWIS Scout

KANSAS

Map No. 77 Sec. 36 Twp. 23 R. 11WWell No. 2 VolkerTranswestern


Company

CORRECTION

Contractor

C E L S W N E

SECTION FLAT

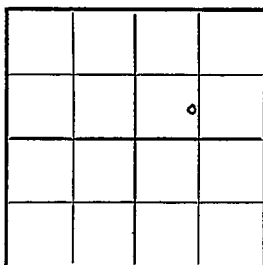

Ft. from N. Line

660

Ft. from S. Line

Ft. from E. Line

990

Ft. from W. Line

Zenith Pool

Location

Rig up

Drilling and Remarks:

They have
changed it from
SW NE

RECORD

Cased _____ in., _____ ft.

Sand _____

Gas _____

Oil _____

Total Depth _____

PRODUCTION

1st 24 hrs. Nat. _____

1st 24 hrs. after shot _____

Gas _____ Cu. Ft.

Dry Hole _____

Abandoned _____

Date

MAR 1 1944 19

S. J. LEWIS

Scout

Pool Name Zenith Pool

KANSAS
 Map No. 77 Sec. 36 Twp. 23 R. 11W

Well No. 2 Volker

Transwestern
 Company

COMPLETED
 Contractor

C E L SW NE

SECTION PLAT

Ft. from N. Line

660

Ft. from S. Line

Ft. from E. Line

990

Ft. from W. Line

Stafford County

RECORD

Location _____

Cased _____ in., _____ ft.

Rig up _____

Sand _____

Drilling and Remarks:

Gas _____

Oil _____

Total Depth 3713

PRODUCTION

1st 24 hrs. Nat. _____

1st 24 hrs. after shot _____

Gas _____ Cu. Ft.

Dry Hole _____

Abandoned _____

Date

APR 19 1944 19

S. J. LEWIS Scout