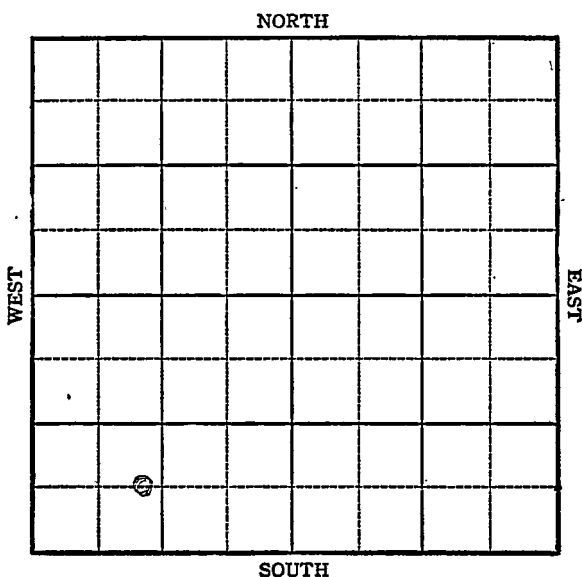


KANSAS

Section 36 Township 23 Range 11WWell No. 2 M. VolkerCompany Republic Nat. Gas

13

KANSAS

Stafford

Sec. 36 Twp. 23 R. 11W

Well No. #2 M Völker Farm

Republic Nat Gas Company

Zenith


 Ft. from N. Line

660 Ft. from S. Line

 Ft. from E. Line

990 Ft. from W. Line

Elev-1807

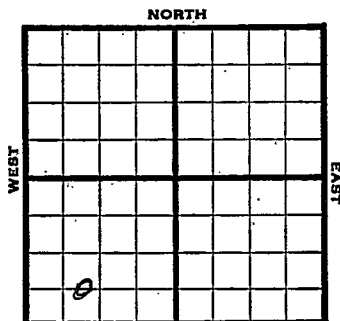

CEL SW SW

1944

REPORT

8/30	Location
9/8	"
9/13	"
9/21	8" @ 325 WOC
9/28	Anhy 505
	Drlg. 2520
10/4	Viola 3711-15 TD
	5" 3711 RUST
10/11	"N " " " "
10/18	Viola 3716
	5" @ 3716
	2500 acid
	Pump 75 pot.
	TD 3735
	Grav. 42.0

COMPLETED

Pool Name Zenith~~KANSAS~~Map No. 47 Sec. 36 Twp. 23 R. 11WWell No. 2 H. VolkerRepublic Nat Gas Company

FIRST REPORT

Contractor

C E L SW SW

SECTION PLAT

 Ft. from N. Line660 Ft. from S. Line Ft. from E. Line990 Ft. from W. Line

Stafford CountyLocation XRig up

Drilling and Remarks:

RECORD

Cased in., ft.Sand Gas Oil Total Depth

PRODUCTION

1st 24 hrs. Nat. 1st 24 hrs. after shot Gas Cu. Ft.Dry Hole Abandoned

Date

AUG 30 1944 19S. J. LEWIS Scout

Pool Name ZenithMap No. 4 KANSAS Sec. 36 Twp. 23 R. 11WWell No. 2 M. Walker

Republic Nat. Gas Company

COMPLETED

Contractor

C E L SW SW

SECTION PLAT

Ft. from N. Line

660 Ft. from S. Line

Ft. from E. Line

990 Ft. from W. Line

Stafford

RECORD

Location

Cased _____ in., _____ ft.

Rig up

Sand _____

Drilling and Remarks:

Gas _____

Oil _____

Total Depth 3785

PRODUCTION

1st 24 hrs. Nat. _____

1st 24 hrs. after shot _____

Gas _____ Cu. Ft.

Dry Hole _____

Abandoned _____

Date

OCT 18 1944 19 S. J. LEWIS Scout