


Stafford

Section 36 Township 23 Range 11W


Well No. #1. O. Volker

Company Transwestern

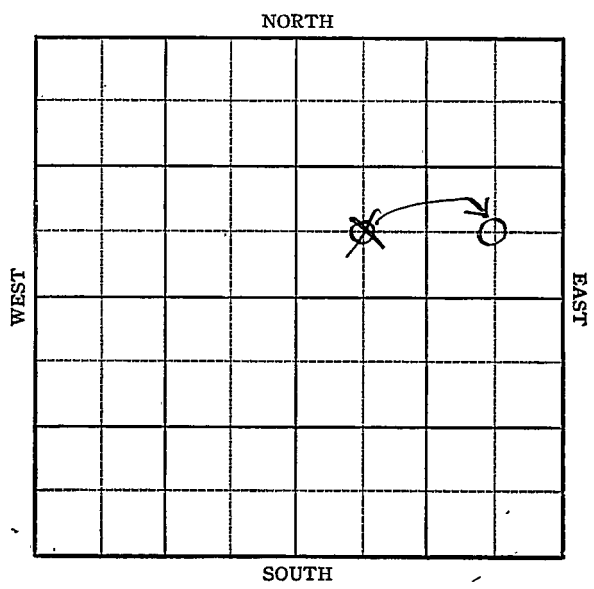

KANSAS

Stafford

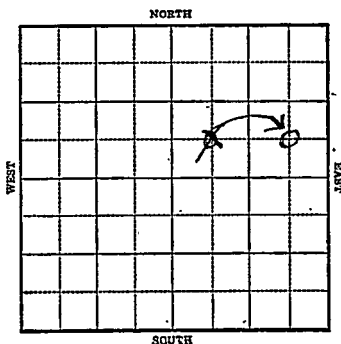Sec. 36 Twp. 23 R. 11-WWell No. #1 O. W. Moller FarmTranswestern Company Ft. from N. Line660 Ft. from S. Line660 Ft. from E. Line~~660~~ Ft. from W. Line

1944

R E P O R T

1/26 Surface hole

2/2 9" @ 333
Drlg. 24002/8 Lams 3302
Minener 3665
Viola 3677
Drlg. 38022/15 SD
TD 3705
5" @ 3701
Rust2/23 500 acid
Flow 64 oil 1st hr 43 oil
5/8" choke per hr 4 hrs.3/1 5" @ 3701
Viola 3677
TD 3705
Bomb Pot. 4444
Max 3000
Gravity 42

COMPLETED

KANSAS

Map No. 47 Sec. 36 Twp. 23 R. 11WWell No. 1 O. Volker

Transwestern

Company

FIRST REPORT

Contractor

C SW NE

SECTION PLAT

		o	

Ft. from N. Line

660

Ft. from S. Line

Ft. from E. Line

660

Ft. from W. Line

Zenith Pool

Location

Rig up

Drilling and Remarks:

Surface Hole

RECORD

Cased _____ in., _____ ft.

Sand _____

Gas _____

Oil _____

Total Depth _____

PRODUCTION

1st 24 hrs. Nat. _____

1st 24 hrs. after shot _____

Gas _____ Cu. Ft.

Dry Hole _____

Abandoned _____

Date

JAN 26 1944 19

S. J. LEWIS Scout

KANSAS
 Map No. 7 Sec. 36 Twp. 23 R. 11W
 Well No. 1 O. Volker

Transwestern


Company

CORRECTION

Contractor

C SE NE

SECTION PLAT

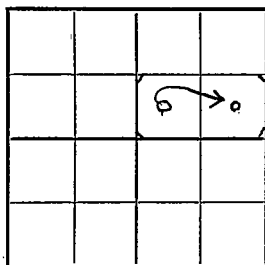

_____ Ft. from N. Line

660 _____ Ft. from S. Line

660 _____ Ft. from E. Line

_____ Ft. from W. Line

Zenith Pool

Location _____

Rig up _____

Drilling and Remarks:

Reported

C SW NE

RECORD

Cased _____ in., _____ ft.

Sand _____

Gas _____

Oil _____

Total Depth _____

PRODUCTION

1st 24 hrs. Nat. _____

1st 24 hrs. after shot _____

Gas _____ Cu. Ft.

Dry Hole _____

Abandoned _____

Date

FEB 2 1944

19

S. J. LEWIS Scout

KANSAS
Map No. 47 Sec. 36 Twp. 23 R. 11W

Well No. 1 O. Volker

Transwestern

Company

COMPLETED

Contractor

C SE NE

SECTION PLAT

 Ft. from N. Line

660 Ft. from S. Line

660 Ft. from E. Line

 Ft. from W. Line

			0

Zenith Pool

Location

Rig up

Drilling and Remarks:

Viola 367?

5" @ 370'

Born + Po + 4444

May 3000

42 e gr

RECORD

Cased in., ft.

Sand

Gas

Oil

Total Depth 8705.

PRODUCTION

1st 24 hrs. Nat.

1st 24 hrs. after shot

Gas Cu. Ft.

Dry Hole

Abandoned

Date

MAR 1 1944 19

S. J. LEWIS

Scout