

Section 36 Township 23 Range 12WWell No. #1 LeimkuehlerCompany Eldorado Ref.

		0					

NORTH

WEST


EAST

SOUTH

Stafford KANSAS ✓

Sec. 36 Twp. 23 R. 12 WWell No. # 1 Leimkuchler FarmEl Dorado Ref. CompanyGroup Explor. ContractorWildcat330 Ft. from N. Line Ft. from S. Line990 Ft. from E. Line Ft. from W. Line

NW NE NW

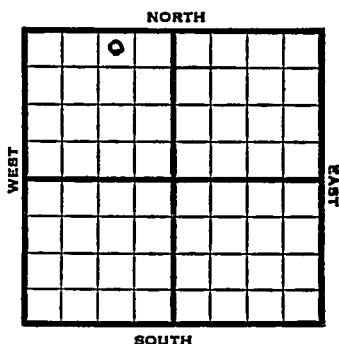

1953

Elev. 1847' REPORT

5/6 Spud 5-5-53


5/20 Spud 5-5-53
 D & A
 TD 3908'
 8" @309'
 Anhy 615 Heeb 3223, Br. Lime 3377,
 Lans 3396
 DST 3488-3500 opn 1 hr, rec 225' sw
 B KC 3660, Viola 3742, Simp 3834, Arb
 3883,
 TD 3908'
 D & A.

ABANDONED

County Stafford State KansasSec. 36 (Blk.) 23 (Sur.) 12W Map No.Operator Eldorado Ref.Well No. 1 Farm LeimkuehlerElev. Location NW NE NW

FIRST REPORT

330 Ft. From W Line NW990 Ft. From E Line Quarter1st. Report MAY 6 1953CompletionRemarksGroup Explor. - Contr.Spudding Date 5-5-53Drlg. Data Wildcat

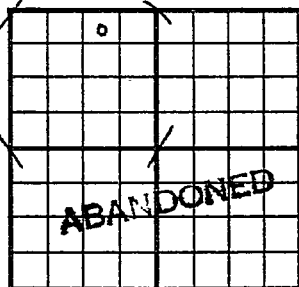County Stafford State KansasSec. 36 (Blk. 23 (Sur. 12W Map No.)
(Twp.) (Rge.)Operator Eldorado Ref.Well No. 1 Farm LeimkuchlerElev. 1847 Location NW NE NW330 Ft. From N Line NW990 Ft. From E Line Quarter1st. Report Completion MAY 20 1953Remarks WildcatGroup Explor- Contr.Spudding Date 5-5-53Drlg. Data D & A TD 39088" @ 309 Anhy 615 Heeb. 3223Br. lime 3377 Lans. 3396 DST 3488-3500open 1 hr. Rec. 225' sw B KC 3660Viola 3742 Simp. 3834 Arb. 3883TD 3908D & A

J. G. McGEHEE