

O.W.W.O.

Hodgeman


KANSAS

SECTION 36 TOWNSHIP 23 RANGE 22 W

WELL NO. #2 Hall

COMPANY Atlantic Ref.

NORTH

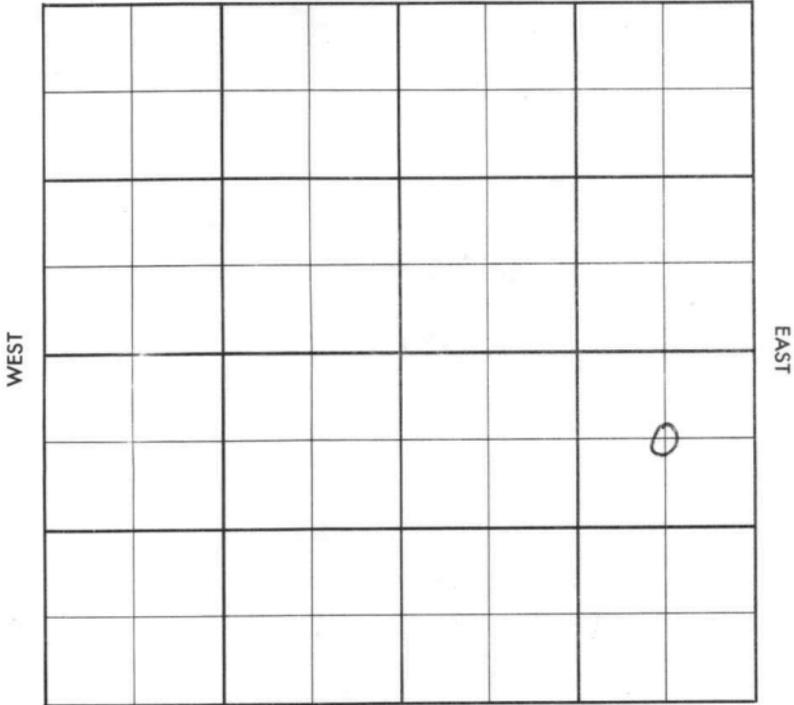

SOUTH

O.W.W.O.

Hodgeman

KANSAS

SEC. 36	TWP. 23	R. 22W
------------	------------	-----------

WELL NO. #2 Hall FARM

COMPANY Atlantic Ref.

CONTRACTOR


Sawlog Creek

_____ Ft. from N. Line

_____ Ft. from S. Line

_____ Ft. from E. Line

_____ Ft. from W. Line

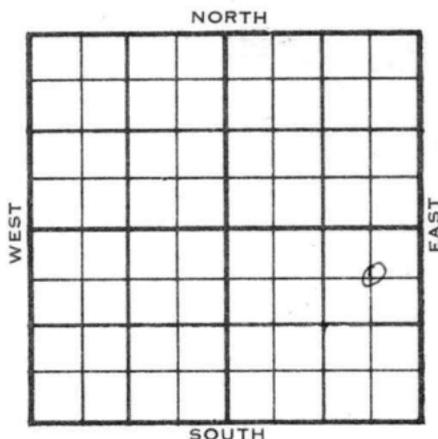

C NE SE

1956	ELEVATION 2286	REPORT
------	-------------------	--------

1-25

Cellar & pits

4-11

Comm. 1-25-56
 8 5/8" @ 254 w/200
 DST 4307-27 op 55 min. rec. 2' mud,
 20/15" Dg. 3901,
 DST 4327-65 op 75 min. gas in 50 min.
 rec. 120' g&mco, 830' sgco, 330' sw
 1340/20" BL. 3931, L. 3943
 DST 4464-85 op 1 hr. gas in 15 min.,
 rec. 615' gco, 1390/30"
 DST 4524-55 op 1 hr. rec. 5' mud,
 25/20" Marm 4235, Ce. 4449
 5 1/2" @ 4591/300 C. 4524
 CO, 32/ 4478-86 M. 4543
 S/ 10.7 bo 9 hrs., 2000 A
 F/ 138 bo 21 hrs., 40/ 4334-44
 S/ 2 bo 11.9 bw, 18 hrs.,
 CO, 24/ 4349-55, 2000 A, #
 S/ 1/2 boph,
 S/ 10.3 bo 24 hrs.,
 CO to 4440, 20/ 4349-54, frac, 1000 A
 S/ 214 bf, 8 1/2 hrs., 19% wtr.
 CO to 4490,
 S/ &F/ 87 bo,
 S/ 18 bo, 4% bs, 3 hrs. OVER
 Comp. 218 bopd
 H. 3846 Tr. 3878
 TD 4595' COMPLETED

1956

O.W.W.O.

6/20

Dual completed - Orig comp from
Chero 4478-86, Phy in Chero 218.4
bopd no wtr (~~400~~ 400)

Now has been completed from both
Chero 4478-86 & Marm 4349-54
plug in Marm 90 BOPD + 33% wtr
~~22~~ 7

6-27

Complete
TD 4595'

COMPLETED

County Hodgeman Elev. _____
 Sec. 36 Twp. 23 Rgs. 22W
 Company Atlantic Ref.
 Farm Name Hall No. 2

TOPS	DEPTH	LOG	DATUM	Loc. in Sec.
Anh.				C NE SE
Tp.				
H.				
Tr.				
Dg.				
Bl.				
L.				Geol. _____
K.C.				Contr. _____
B.K.C.				
Ce.				
C.				
M.				Pool _____
K.				Sawlog Creek
Mz.				
Mq.				
V.				
S.				
S.				
A				
R.				
Pf.				
G.				
T.D.				

FIRST REPORT
 JAN 25 1956

Date Comm. _____
Cellar & pits

Handwritten signature

Co.
Lse.
No.
Sec.
T.
R.

County Hodgeman Elev. 2286
 Sec. 36 Twp. 23 Rge. 22W
 Company Atlantic Ref.
 Farm Name Hall No. 2

TOPS	DEPTH	LOG	DATUM
Anh.			
Tp.			
H.	<u>3846</u>		
Tr.	<u>3878</u>		
Dg.	<u>3901</u>		
Bl.	<u>3931</u>		
L.	<u>3943</u>		
K.C. <u>manm</u>	<u>4235</u>		<u>1657</u>
B.K.C.			<u>1949</u>
Ce.	<u>4449</u>		<u>2163</u>
C.	<u>4524</u>		<u>2238</u>
M.	<u>4543</u>		<u>2257</u>
M.			
K.			
Mz.			
Me.			
V.			
S.			
S.			
A.			
R.			
PE.			
G.			
T.D.	<u>4595</u>		

Loc. in Sec. C NE SE
 Geol. _____
 Contr. _____
 Pool Sawlog Creek

COMPLETE		
		0

Date Comm. 1-25-56 APR 11 1956
8 5/8" @ 254/200 DST 4307-27

open 55 min. rec. 2' mud 20/15"
 DST 4327-65 open 75 min. gas in 50 min
 rec. 120' g & mco 830' sgco 330' sw
 1340/20" DST 4464-85 open 1 hr.
 gas in 15 min. rec. 615' gco 1390/30"
 DST 4524-55 open 1 hr. rec. 5' mud
 25/20" 5 1/2" @ 4591/300 -CO

OVER

32/ 4478-86 S/ 10.7 bo 9 hr.

2000 A F/ 138 bo 21 hr.

40/ 4334-44 S/ 2 bo 11.9 bw 18 hr.

CO 24/ 4349-55 2000 A S/ $\frac{1}{2}$ boph

S/ 10.3 bo 24 hr. CO to 4440

20/ 4349-54 frac 1000 A S/ 214 bf

$8\frac{1}{2}$ hr. 19% wtr. CO to 4490

S/ & F/ 87 bo S/ 18 bo 4% bs 3 hr.

Comp. 218 bopd


R. G.

APR 19 1956

O.W.W.O.

FORM 513 SUNRAY

County Hodgeman Elev. _____
 Sec. 36 Twp. 23S Rge. 22W
 Company Atlantic Ref.
 Farm Name Hall No. 2

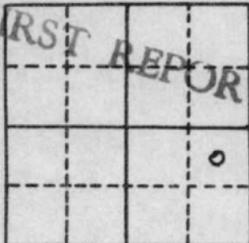TOPS	DEPTH	LOG	DATUM	Loc. in Sec.
Anh.				C NE SE
TP.				
H.				
Tr.				
Dg.				
Bl.				
L.				Geol. _____
K.C.				Contr. _____
B.K.C.				
Ce.				
C.				
M.				
M.				Pool
K.				<u>Sawlog Creek</u>
Mz.				<div style="border: 1px dashed black; padding: 5px; display: inline-block;"> FIRST REPORT  </div>
Me.				
V.				
S.				
S.				
A.				
R.				
PE.				
G.				
T.D.				

Date Comm. JUN 20 '56

Dual completed - originally comp. from
 Chero. 4478-86; Phy. in Chero. 218.4 bopd
 no wtr. (400); Now has been completed Brom
 both Chero 4478-86 & Marm. 4349-54;
 plug in Marm. 90 bopd + 33% wtr.

M.M.

/

Co. No. Sec. T. R.

Co.

County Hodgeman Elev. _____
 Sec. 36 Twp. 23S Rge. 22W
 Company Atlantic Ref.
 Farm Name Hall No. 2

TOPS	DEPTH	LOG	DATUM
Anh.			
TP.			
H.			
Tr.			
Dg.			
Bl.			
L.			
K.C.			
B.K.C.			
Ce.			
C.			
M.			
M.			
K.			
Mz.			
Ma.			
V.			
S.			
S.			
A.			
R.			
PE.			
G.			
J.D.	<u>4595</u>		

Loc. in Sec. C NE SE

Geol. _____

Contr. _____

Pool

Sawlog Creek

COMPLETE		
		o

Lse.

No.

Sec.

T.

R.

Date Comm. JUN 27 '56

Dual completed - originally comp. from
 Chero. 4478-86; Phy. in Chero. 218.4 bopd
 no wtr. (400); Now has been completed from
 both Chero 4478-86 & Marm. 4349-54;
 plug in Marm. 90 bopd + 33% wtr. JUN 27 '56

complete

⊕