


Section 36 Township 23 Range 22W

Well No. #1 Miller

Company Atlantic Ref.

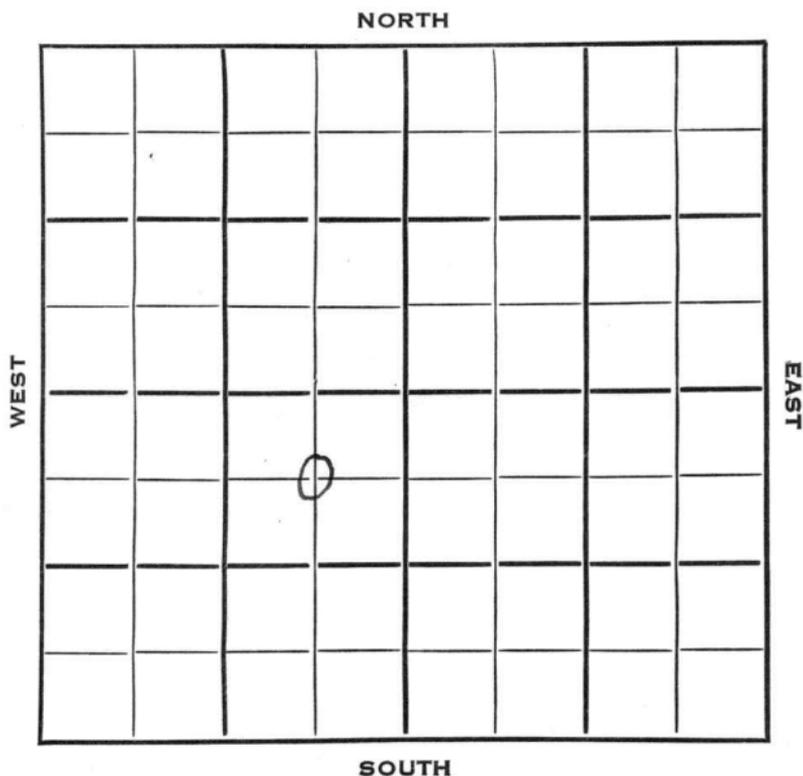

Hodgeman

KANSAS

SEC.	TWP.	R.
36	23	22W

WELL NO.

#1 Miller

FARM

COMPANY

Atlantic Ref.

CONTRACTOR


Holme

660 Ft. from N. Line

Ft. from S. Line

660 Ft. from E. Line

Ft. from W. Line

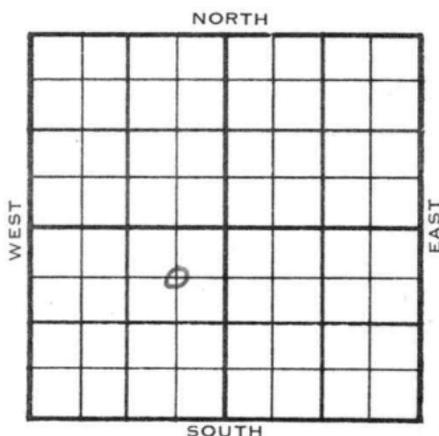

C NE SW

	ELEVATION	REPORT
1953	2281'	
9/30	Location	
10/7	8" @ 307' w/225 sks Drlg 2960'	
10/14	Top 3467, Heeb 3848, Tor 3872, Doug 3900, Br. L. 3931, Lans 3942, Marm 4228' DST 4267'-97' 1 hr, 8' M 50#.	
10/28	Spud 10-1-53 D & A TD 4558' 8" @ 307 Top 3467 Heeb 3848 Tor. 3872 Doug. 3900 Br. lime 3931 Lans. 3942' Marm. 4228' DST 4267-97 open 1 hr rec 8' mud 50# DST 4327-50 open 1 hr rec 170' OCM 20% oil 150' SW 810# DST 4466-86 open 1½ hr rec 100' GCM 20' HO & GCM 70# Cong. 4517' Miss 4536' DST 4537-58 open 1½ hr rec 35' mud TD 4558' D & A	

ABANDONED

County Hodgeman State Kansas

Sec. 36 (Blk.) 23 (Sur.) 22W Map No.

Operator Atlantic Ref.

Well No. 1 Farm Miller

Elev. 2281 Location C NE SW

660 Ft. From N Line SW

660 Ft. From E Line Quarter

1st. Report

Completion OCT 28 1953

Remarks

Holme - Contr.

Spudding Date 10-1-53

Drilg. Data D & A TD 4558

8" @ 307 Top. 3467 Heeb. 3848

Ter. 3872 Doug. 3900 Br. lime 3931

Lans. 3942 Marm. 4228 DST 4267-97

open 1 hr. Rec. 8' mud 50# DST 4327-

50 open 1 hr. Rec. 170' ocm 20% oil

150' sw 810# DST 4466-86 open 1 1/2 hr.

Rec. 100' gcm 20' ho & gcm 70#

Cong. 4517 Miss. 4536 DST 4537-58

open 1 1/2 hr. Rec. 35' mud TD 4558

D & A