


Hodgeman

KANSAS

Section 36 Township 23 Range 22W

Well No. #1 Ross E. Hall

Company Atlantic Refining Company

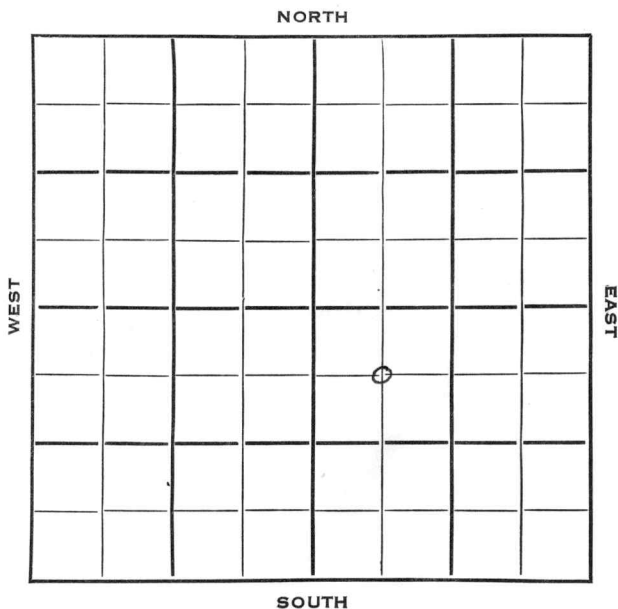

Hodgeman

KANSAS

Sec. 36 Twp. 23 R. 22W

Well No. #1 Ross E. Hall Farm

Atlantic Company

Contractor

Wildcat


660 Ft. from N. Line

Ft. from S. Line

Ft. from E. Line

660 Ft. from W. Line

C NW SE

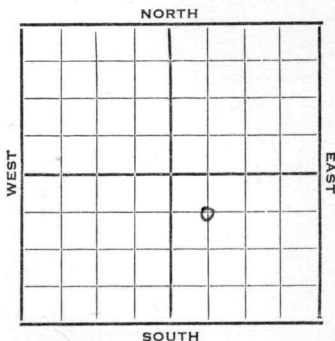

1953 Elev. 2269' REPORT

2/25 Location

3/12 10" @ 276
Drlg. 3621'

3/19 Heeb 3816, Tor 3839, Br li 3897,
Lans 3910
DST 4063-75, 1 hr., gas in 10",
3370' gassy oil, G 21
1470#
Drlg. 4350'

3/26 DST 4434-55, 1 hr, 140' SO & GCM
60' MCO 120' clean oil Grav 40.2
1215# FFP 75# Miss 4509
DST 4508-16, 1 hr, 3' M 0#
DST 4516-25, 1 hr, 3' M
DST 4570-4608, 10' M
DST 4568-4608, 40' M 340' SW
1420# FFP 230#
Drlg. 4671'

4/2 TD 4982
7" @ 4980

4/9 NR

4/16 NR

4/23 "

4/30 "

5/7 NR

OVER

1953

5/21

B/120 BO 12 hrs.

5/27

Spud 2-27-53

Oil Well

TD 4982

10" @ 276

Heeb 3816, Tor 3839, Br lime 3897,

Lans 3910

DST 4063-75, opn 1 hr., rec. 480'

sul wtr., 1430#

DST 4283-4317, opn 1 hr., gas in 10 mins., rec. 3390' gassy oil, 1470#

DST 4434-55, opn 1 hr., rec. 140'

so & gcm, 60' mco, 120' cleannoil

1215#

Miss 4509

DST 4508-16, opn 1 hr., rec. 3' mud, 0#

DST 4516-25, opn 1 hr., rec. 3' mud, 0#

DST 4570-4608, opn 1 hr., rec. 10' mud

DST 4568-4608, opn 40 mins., rec. 340' sw, 1420#

DST 4476-4501, opn 1 hr., rec. 5' mud

DST 4680-4708, opn 1 hr., rec. 110' mud, 1450#

TD 4982 - 7" @ 4980,

Meisner 4775, Viola 4865, Simp 4907, Arb 4923

30/4517-22, dry; 36/4511-17 dry; SP 4496; 1500A; S/6 bwph & SO; S/3 bo 7 $\frac{1}{4}$ bwph 14 hrs; S/2 bo 5 bwph 20 hrs;

42/4448-55; 36/4437-43; SP 4423; sq/4437-55; CO to 4476; 42/4448-55 dry; 500^A; S/51 $\frac{1}{2}$ bf 24 hrs; 77% oil; S/34 $\frac{1}{2}$ bo 10 $\frac{1}{4}$ bwph; 36/4437-43 500A; S/35 bo X 7 $\frac{1}{2}$ bwph; SP 4420; 66/4284-95;

B/5 go 250A; S/10 boph 2000A; S/1060 bopd on 4 hr test; S/53 boph 3 hrs; P/132 bopd 2% wtr; P/120 bo 12 hrs. Comp. 695 bopd 6% wtr.

COMPLETED

County Hodgeman State KansasSec. 36 (Blk.) 23 (Sur.) 22W Map No.Operator AtlanticWell No. 1 Farm Ross E. HallElev. Location C NW SE660 Ft. From N Line SE660 Ft. From W Line Quarter1st. Report FEB 25 1953


Completion

Remarks

Spudding Date

Drig. Data WildcatLocation

County Hodgeman State Kansas
 Sec. 36 (Blk.) 23 (Sur.) 22W Map No.
 Operator Atlantic
 Well No. 1 Farm Ross E. Hall
 Elev. 2269 Location C NW SE

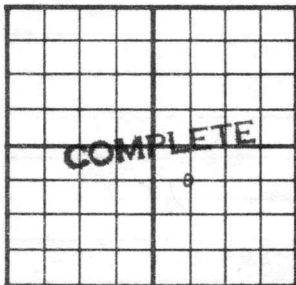

660 Ft. From N Line SE
660 Ft. From W Line Quarter
 1st. Report
 Completion MAY 27 1953
 Remarks Wildcat
 Spudding Date 2-27-53

Drlg. Data Oil well TD 4982
10" @ 276 Heeb. 3816 Tor. 3839
Br. lime 3897 Lans. 3910 DST 4063-75
open 1 hr. Rec. 480' sul. wtr. 1430#
DST 4283-4317 open 1 hr. gas in 10 min.
Rec. 3390' gassy oil 1470# DST 4434-55
open 1 hr. Rec. 140' so & gcm 60' mco
120' clean oil 1215# Miss. 4509
DST 4508-16 open 1 hr. Rec. 3' mud
O# DST 4516-25 open 1 hr. Rec. 3' mud
O# DST 4570-4608 open 1 hr. Rec.
10' mud DST 4568-4608 open 40 min.
Rec. 340' sw 1420# DST 4476-4501
open 1 hr. Rec. 5' mud DST 4680-4708
open 1 hr. Rec. 110' mud 1450#

J. G. McGEHEE

Drlg. Data

TD 4982 7" @ 4980 Meisener 4775

Viola 4865 Simp. 4907 Arb. 4923

30/ 4517-22 dry 36/ 4511-17 dry

SP 4496 1500 A S/ 6

S/ 3 bo 7 $\frac{1}{2}$ bwph 54 hr. 5 bwph

20 hr. 42/ 4448-55

SP 4423 sq/ 4447-55

42/ 4448-55 dry 500 A S/ 51 $\frac{1}{2}$ bf

24 hr. 77% oil S/ 34 $\frac{1}{2}$ bo 10 $\frac{1}{4}$ bwpd

36/ 4437-43 500 A S/ 35 bo 7 $\frac{1}{2}$ bwpd

SP 4420 66/ 4284-95 B/ 5 go 250 A

S/ 10 boph 2000 A S/ 1060 bopd on

4 hr. test S/ 53 boph 3 hr.

P/ 132 bopd 2% wtr. P/ 120 bo 12 hr.

Comp. 695 bopd 6% wtr.