


DX 78-1

HODGEMANN

KANSAS

Section 36 Township 23S Range 22W  
Well No. #2 Miller  
Company The Atlantic Ref. Co.

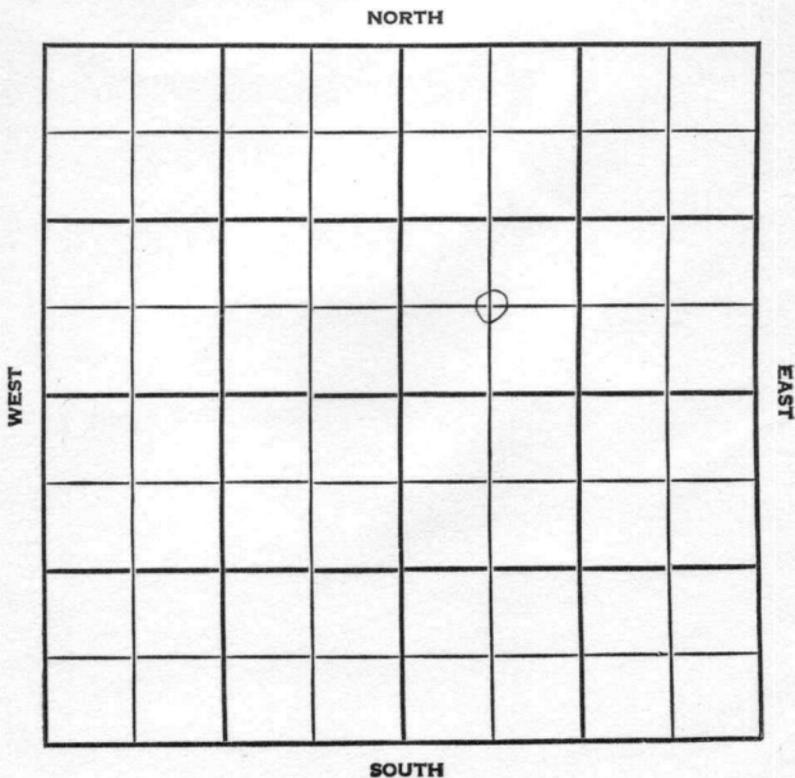

Hodgeman

KANSAS

SEC.

TWP.

R.

36

23S

22W

WELL NO.

2 Miller

FARM

COMPANY

The Atlantic Refg. Co.

CONTRACTOR

Lewis

Sawlog Creek


\_\_\_\_\_ FT. FROM N. LINE

\_\_\_\_\_ FT. FROM S. LINE

\_\_\_\_\_ FT. FROM E. LINE

\_\_\_\_\_ FT. FROM W. LINE

C SW NE

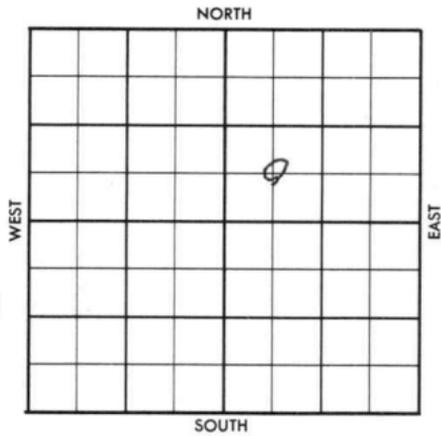

1956	ELEVATION 2262'	REPORT
6-20	6-15-56	8" @ 210 w/200 Drlg. 2475'
8-22	DST 4292-4337 op 1 hr, rec. 640' black gssy oil, BHP 370/15". DST 4439-60 op 1 hr., rec. 20' mud, BHP 40/15". FP 4-6 5 1/2" @ 4551 w/300 28/4324-31 S/ 110 BO ≠ 28% BSW, 6 hrs. PB 28/4293-4300 S/ 52.4 BR, 24% wtr., CO 4519 P/ 134 BO ≠ 56 BW, 24 hrs. P/ 105.84 BO ≠ 37.64 BW, 24 hrs. P/ 282 BO ≠ 22% wtr., Grav. 22. H. 3817'; Bl. 3899'; L. 3911'; Marm 4210'; Ft. Sct. 4381'; Ce. sh. 4421'; Cg. 4485'; Miss. 4504'; TD 4560'	<b>COMPLETED</b>



4304  
2262  
2262

FORM 513 SUNRAY

County Hodgeman Elev. 2262  
 Sec. 36 Twp. 23S Rge. 22W  
 Company The Atlantic Ref. Co.  
 Farm Name Miller No. 2

TOPS	DEPTH	LOG	DATUM	Loc. in Sec.
Anh.				C SW NE
TP.				
H.	3877			
Tr.				
Dg.				
BL.	3899			
L.	3911			Geol.
K.C.				
B.K.C.				Contr.
Ce.	Marm 4210			Lewis
E.	Et set 4381			
M.	ce sh 4421			Pool
M.	cg 4485			Sawlog Creek
K.	Miss 4504			
Mz.				
Me.				
V.				
S.				
S.				
A.				
R.				
PE.				
G.				COMPLETE
TD.	4560			

Date Comm. 6-15-56 AUG 22 1956

8" 210 w/200; D 2475 JUN 27 '56 4182

21. 3 '56 DST 4292-4337 1hr

640' Black gassy oil BHP

370/15 DST 4439-60 1hr run

20' Md BHP 40/15 FP 4-6

JUL 11 '56 5 1/2 4551/300 WOCT JUL 18 '56

28/ 4324-31 A \$ 110 BO

+ 28 40 BSW 6 hrs JUL 25 '56 PB

28/ 4293-4300 A \$ 52.4 BF

2490 wtr CO 4519 AUG 1 '56

AUG 8 '56

AUG 15 '56

AUG 22 '56

P. 134

B0 + 56 BW 24 hrs P. 105.84

B0 + 37.64 BW 24 hrs Ph P.

282 B0 + 2290 wtr

graw 22°

36-23-224

0.30 NE