


Section 36 Township 23 Range 33 W

Well No. # 1 H. P. Winget

Company Northern Pump

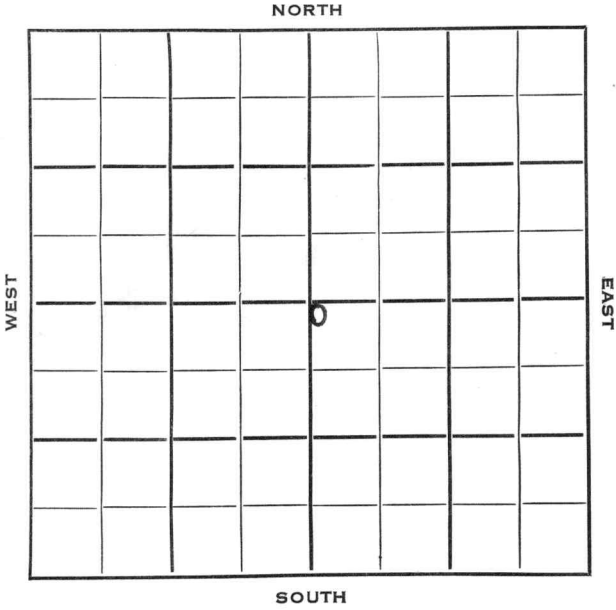

Sec. 36 Twp. 23 R. 33W

Well No. #1 H. P. Winget Farm

Northern Pump Company

Contractor


150 Ft. from N. Line

Ft. from S. Line

Ft. from E. Line

150 Ft. from W. Line

NW NW SE

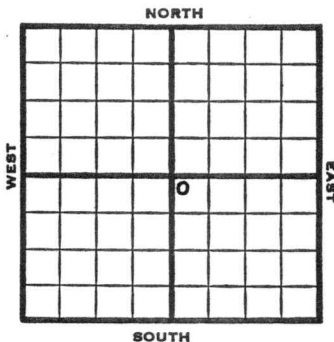

1953 Elev. 2880' REPORT

5/13 Spud 5-11-53  
10" @ 362, WOC

5/21 Her 2541, Kr 2562, Win 2596  
RTD 2610  
7" @ 2598

5/28 NR

6/3 NR

6/10 NR

6/17 Spud 5-11-53 Gas well TD 2610  
10" @ 362 Her 2541 Kri. 2562  
Win. 2596 TD 2610 7" @ 2598  
CO to 2597 5/2586 5/2558 CO to 2610  
2000 dol-frac PB 2581 60/2544-54  
78/2565-78 5000 A CO to 2610  
1000 A  
Comp. 4,700,000 gas.

COMPLETED



