

Section 36 Township 23 Range 34WWell No. #1 JossCompany Champlin Ref.

NORTH

				o			

WEST

EAST

SOUTH

Finney

KANSAS

Sec. 36 Twp. 23 R. 34W ✓

Well No. #1 Joss Farm

Champlin Ref. Company

Hugoton Pool Contractor


330' Ft. from N. Line

_____ Ft. from S. Line

_____ Ft. from E. Line

330' Ft. from W. Line

NW NW SE

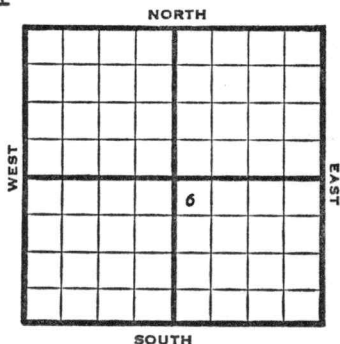

1950

Elev. 2924

REPORT

11/29

Location

1951

1/31

Spud 12/17/50

Gas Well TD 2626

10" @407

Her. 2431 Krider 2462 Win. 2528

Towanda 2580

TD 2626


7" @2625 120/ 2594-2614 42/ 2587-88

26/ 2528-44 108/ 2485-2503 96/ 2465-

78 48/ 2434-42 24000 A

Comp. 2,185,000 gas

COMPLETED

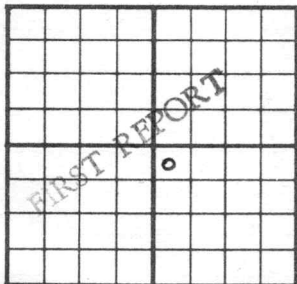County Finney State KansasSec. 36 (Blk. Twp.) 23 (Sur. Rge.) 34W Map No.Operator Champlin Ref.Well No. 1 Farm JossElev. _____ Location NW NW SE330 Ft. From N Line SE330 Ft. From W Line Quarter1st. Report NOV 29 1950

Completion _____

Remarks _____

Spudding Date _____

Drlg. Data Hugoton PoolLocation

J. E. TYRA

J. E. TYRA