

KANSAS

Kearny

Section 36 Township 23 Range 36WWell No. 1 MorrisCompany Stanolind**Hugoton**

NORTH

WEST

EAST

SOUTH

KANSAS

Kearney

HOT FILE

Sec. 36 Twp. 23 R. 36W ✓

Well No. #1 Morris Farm

Stanolind Company


Hugoton Pool

50' Ft. from N. Line

 Ft. from S. Line

 Ft. from E. Line

350' Ft. from W. Line

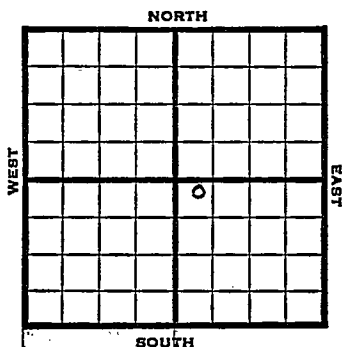

NW SE

1949 Elev 3103' REPORT

3/16 10" @ 709'

3/23 2613 fsg.

3/29 TD 2745'
5" @ 2700'

4/6 TD 2745'
5" @ 2700'
16000 acid
DA 1,359,000 Gas
420# R Pr.
Comp

COMPLETED

Map No. _____ Sec. 36 Twp. 23 R. 36W

Well No. 1 Morris

Stanolind Company

FIRST REPORT

Contractor _____

NW SE


SECTION FLAT

50 Ft. from N. Line

_____ Ft. from S. Line

_____ Ft. from E. Line

350 Ft. from W. Line

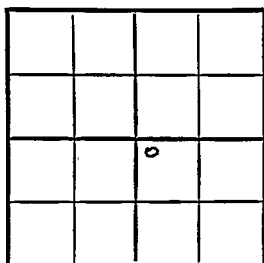

Kearny County

RECORD

Location _____

Cased _____ in., _____ ft.

Rig up _____

Sand _____

Drilling and Remarks:

Gas _____

Oil _____

Total Depth _____

10" @ 709'

PRODUCTION

1st 24 hrs. Nat. _____

1st 24 hrs. after shot _____

Gas _____ Cu. Ft.

Dry Hole _____

Abandoned _____

Date

MAR 16 1949

19

S. J. LEWIS

Scout

Map No. _____ Sec. 36 Twp. 23 R. 36W

Well No. 1 Morris

Stanolind

Company

COMPLETE

Contractor

NW SE

E 1,3123


SECTION PLAT

50 Ft. from N. Line

_____ Ft. from S. Line

_____ Ft. from E. Line

350 Ft. from W. Line

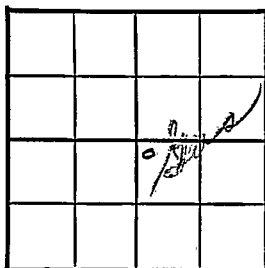

Kearny County

Location _____

Rig up _____

Drilling and Remarks:

5" C 2700

16000 and

Dec. 1, 359,000 Gas

425 # R/P

RECORD

Cased _____ in., _____ ft.

Sand _____

Gas _____

Oil _____

Total Depth 2745

PRODUCTION

1st 24 hrs. Nat. _____

1st 24 hrs. after shot _____

Gas _____ Cu. Ft.

Dry Hole _____

Abandoned _____

Date

APR 6 1949

19

S. J. LEWIS

Scout