

Hamilton


KANSAS

SECTION 36 TOWNSHIP 23 RANGE 39W

WELL NO. #1 Wilcox

COMPANY Kansas-Nebraska

NORTH

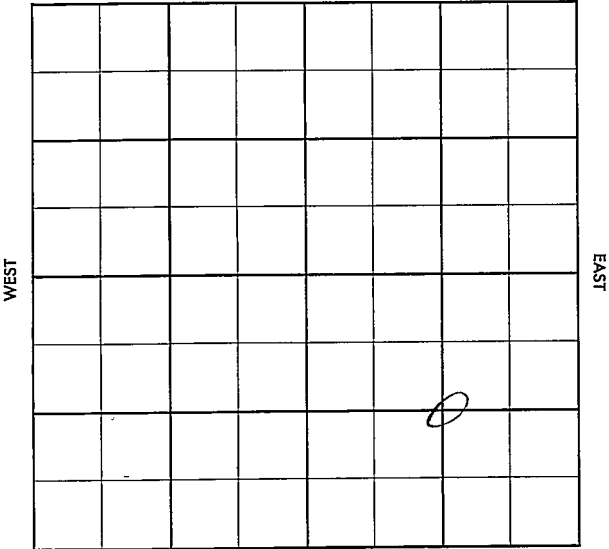

SOUTH



County Hamilton Elev. 3330  
 Sec. 36 Twp. 23 Rge. 39W  
 Company Kansas-Nebr.  
 Farm Name Wilcox No. 1

Sample

TOPS	DEPTH	LOG	DATUM
Anh. <u>Herr</u>		<u>2514</u>	
Tp. <u>KRI</u>		<u>2536</u>	
H. <u>WEd</u>		<u>2580</u>	
Tr. <u>U. FT K14</u>		<u>2644-58</u>	
Dg. <u>6" "</u>		<u>2693</u>	
Bl. <u>Reep</u>		<u>2806</u>	
L. <u>Flor FIT</u>		<u>2758</u>	
K.C. <u>TP</u>		<u>3542</u>	
B.K.C. <u>H6</u>		<u>3757</u>	
Ce. <u>LS9</u>		<u>3876</u>	
C. <u>MW</u>	<u>4914</u>		
M.	<u>5151</u>		
K. <u>St Louis</u>		<u>5251</u>	
Mz.			
Mo.			
V.			
S.			
S.			
A.			
R.			
PE.			
G.			
TD.	<u>5351</u>	<u>2808</u>	

Loc in Sec. C SE/4

Geol.

Contr.

Honaker Drlg

Tools

Pool

Wildcat

COMPLETE  
 JAN 16 '77

Date Comm.

Location WOR Deep Test, LTD 5500 SEP 26 '56  
9-19-56 12 3/8 314/250  
Ø 2400 OCT 3 '56 Ø 3777 OCT 10 '56  
Ø 4750 OCT 17 '56 Ø ST 5111-89 421  
1hr rec 330' SWCM + 1800' 56c  
SW FP 440-1005 BHP 1100/20"  
Ø 5311 OCT 24 '56 5 1/2 2705/250 MICT  
OCT 31 '56 CO 2620 120/2568-98 13  
SSG + 70 GWPH NOV 7 '56 CO 2565

721 2536-54 Frac S56  
 + 60 Gwph PB 2520 20/2554  
 -14 L S55 NOV 13 '56 Frac CO 2620  
 NOV 21 '56 V NOV 28 '56 DEC 7 '56 X DEC 12 '56 JLL 19 '56  
 DEC 26 '56 JAN 1 '57 JAN 1 '57 JAN 1 '57

est ga 200 MCF 2" T69  
 est RP 395 # complete  
 for S. L. 225 well.