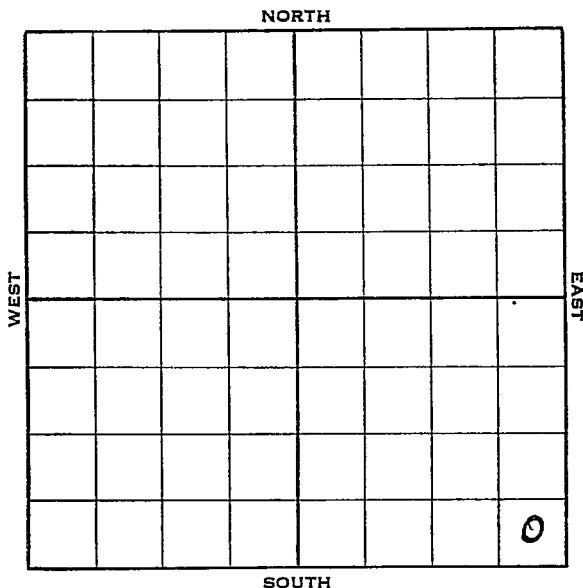


Harvey

KANSAS

Section 4 Township 23 Range 3-WWell No. 1 LagreeCompany ~~Lanshan Drilg.~~ Garden et al

O. W. D. D

KANSAS


Harvey

Sec. 4 Twp. 23 R. 3-WWell No. #1 Lagree Farm~~Lanahan Drilling~~ Garden et al Company

Ft. from N. Line

330 Ft. from S. Line330 Ft. from E. Line

Ft. from W. Line

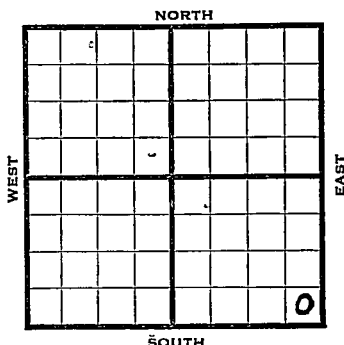

Elev. 1475

1938		REPORT
		O. W. D. D.
8/31	R. R.	1939
9/9	10" - 280'.	1/20 TD 280' SD.
9/16	Shut down.	1/27 " "
9/23	" "	2/3 " "
9/30	" "	2/10 " "
10/7	" "	
10/14	" "	
10/21	" "	2/15 Abd. at 280'
10/28	" "	ABANDONED
11/4	" "	
11/12	" "	
11/18	" "	
11/25	" "	
12/2	" "	
12/9	TD 280' SD.	
12/15	" "	OVER
12/23	" "	
12/30	" "	
1939		
1/6	" "	
1/13	" "	

O. W. D. D

1939

5/17 Old T.D. 280'
15" - 60"
10" - 280'
Drig. 2530'

5/26

K. C. 2530' B.K.C. 2975'
Chat. 3259' Drig. 3331' no show

5/31

Chat. 3259'
S.S.O. 3367-72'
T.D. 3430'

ABANDONED

Harvey

KANSAS

Map No. 39 Sec. 4 Twp. 23 R. 3WWell No. 1 LagreeLanahan Drlg.

Company

Contractor

FIRST REPORT

SE/C

 Ft. from N. Line330 Ft. from S. Line330 Ft. from E. Line Ft. from W. Line

SECTION PLAT

			0

Location Rig up

Drilling and Remarks:

RR

RECORD

Cased in., ft.Sand Gas Oil Total Depth

PRODUCTION

1st 24 hrs. Nat. 1st 24 hrs. after shot Gas Cu. Ft.Dry Hole Abandoned

Date

AUG 31 1938

19

H. D. Hatfield

Scout

Harvey **KANSAS**Map No. 39 Sec. 4 Twp. 23 R. 3WWell No. 1 LagreeLanahan Drlg.

Company

Contractor

ABANDONED
SE/C**SECTION PLAT**

			6

 Ft. from N. Line330 Ft. from S. Line330 Ft. from E. Line Ft. from W. Line**WILDCAT**Location Rig up

Drilling and Remarks:

*abd @ 280***RECORD**Cased in., ft.Sand Gas Oil Total Depth **PRODUCTION**1st 24 hrs. Nat. 1st 24 hrs. after shot Gas Cu. Ft.Dry Hole Abandoned

Date

FEB 15 1939 19**H. D. Hatfield**

Scout

Harvey

KANSAS

Map No. 39 Sec. 4 Twp. 23 R. 3WWell No. 1 LagreeGarden etal

Company

Contractor

FIRST REPORT

SE/C

SECTION PLAT

			0

 Ft. from N. Line330 Ft. from S. Line330 Ft. from E. Line Ft. from W. Line

WILDCAT

Location Rig up

Drilling and Remarks:

OWDD-OTD 280

15" @ 60
10" @ 280

Drlg. 2530

RECORD

Cased in., ft.Sand Gas Oil Total Depth

PRODUCTION

1st 24 hrs. Nat. 1st 24 hrs. after shot Gas Cu. Ft.Dry Hole Abandoned

Date

MAY 17 1939

19

S. J. LEWIS

Scout

Harvey

KANSAS

Map No. 39 Sec. 4 Twp. 23 R. 3WWell No. 1 LagreeGarden etal

Company

Contractor

ABANDONED

SE/C

SECTION PLAT

			0

 Ft. from N. Line330 Ft. from S. Line330 Ft. from E. Line Ft. from W. Line

WILDCAT

Location Rig up Drilling and Remarks: Chas 3259SSO3367-72

RECORD

Cased in., ft.Sand Gas Oil Total Depth 3430

PRODUCTION

1st 24 hrs. Nat. 1st 24 hrs. after shot Gas Cu. Ft.Dry Hole Abandoned

Date

MAY 31 1939 19

S. J. LEWIS

Scout