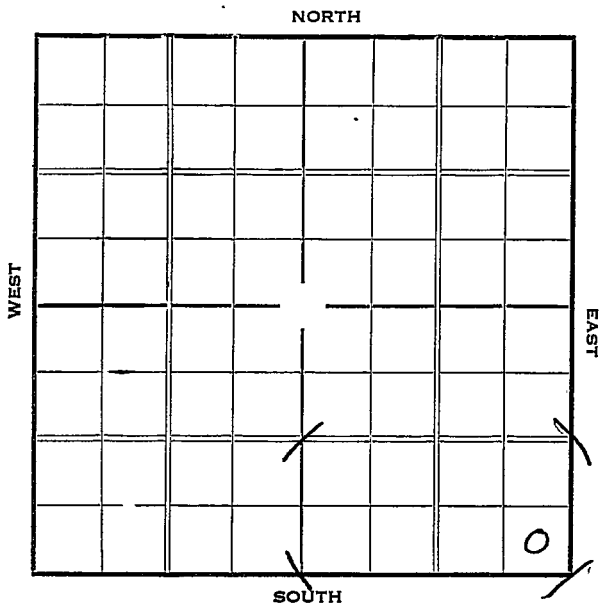


O.W.W.O.

Section 4 Township 23 Range 12-WWell Number # 1 R. B. Dale
S. AndreaCompany ~~Lowenstein & Co.~~
~~Trigg & Vernon Oil~~ Richards*Special*

O.W.W.O.

Sec. 4 Twp. 23 R. 12-W

Well No. #1 R.B. Dale
S. Andrea Farm

~~Lowenstein et al~~ **Richards**

~~Trigg & Vernon Oil~~ Company


1.14 Ft. from N. Line

330 Ft. from S. Line

330 Ft. from E. Line

1.14 Ft. from W. Line

Elev. 1839

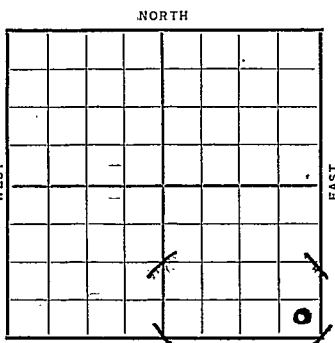

SE SE SE

Special

Date 1937 REPORT

2/10 Location

2/18 Rig

2/26 "

3/4 Rig & Tools

3/11 12" @ 190' WOC

3/18 Anhydrate 615' Drlg. 2470'

3/25 Drlg. 3150'.

4/2 Lansing 3310', Viola 3617',
Simpson 3635'.. Drlg. 3747'

4/7 Sil. 3693'.

T. D. 3735'.

ABANDONED

1953 O.W.W.O.

2/4 Lans. 3310' Cong. 3590' Viola 3617'
Simp. 3635' Arb. 3693' OTD 3735'
D & A

MIR

2/12 DD 3751 Schl
5" @ 3750

2/19 NR

OVER

#1 R. B. Dale

1953
2/25

D&A

TD 3751

Lans 3310, Cong 3590, Viola 3617,

Simp 3635, Arb. 3693

OTD 3735

DD 3751

5" @ 3750

CO to 3724

6/3472-74, 9/348-83, 12/3632-36,

8/3702-04, 8/3708-10, 16/3712-16,

7/3718-20, 500A VSS0 2000A

SP 3464

12/3457-60, 500A dry

SP 3360 20/3336-41, 6/3351-53

D&A


ABANDONED

KANSAS

Map No. 47 Sec. 4 Twp. 23 R. 12WWell No. 1 S. AnshraTrigg & Vernon Oil CompanyJ. Contractor

Special

SECTION PLAT

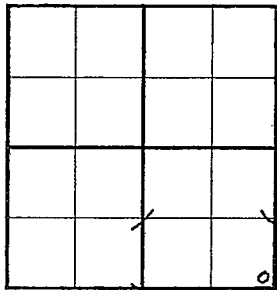 Ft. from N. Line380 Ft. from S. Line330 Ft. from E. Line Ft. from W. Line

FIRST REPORT

Location ✓Rig up

Drilling and Remarks:

RECORD

Cased in., ft.Sand Gas Oil Total Depth

PRODUCTION

1st 24 hrs. Nat. 1st 24 hrs. after shot Gas Cu. Ft.Dry Hole Abandoned

Date

FEB 10 1937

19

S. J. LEWIS Scout

KANSAS*Stafford*Map No. 47 Sec. 4 Twp. 23 R. 12WWell No. 1 S AndreaTrigg & Vernon CompanyTrigg Contractor**SECTION PLAT**

11 Ft. from N. Line330 Ft. from S. Line330 Ft. from E. Line Ft. from W. Line**ABANDONED**Location Rig up

Drilling and Remarks:

*Sil 3693***RECORD**Cased in., ft.Sand Gas Oil Total Depth 3735**PRODUCTION**1st 24 hrs. Nat. 1st 24 hrs. after shot Gas Cu. Ft.Dry Hole ✓Abandoned ✓

Date

APR 7 1911

S. J. LEWIS

Scout

[illegible]

Spudding Date

M I B

J. G. McGEHEE

Map No. _____ Sec. 4 Twp. 23 R. 12WWell No. 1 R. B. Dale_____Richards_____
Company_____CORRECTION_____
Contractor

SE SE SE

SECTION PLAT

			o

_____Ft. from N. Line330 Ft. from S. Line330 Ft. from E. Line_____Ft. from W. LineStafford County

Location _____

Rig up _____

Drilling and Remarks:

Reported
Lowenstein et al.

RECORD

Cased _____ in., _____ ft.

Sand _____

Gas _____

Oil _____

Total Depth _____

PRODUCTION

1st 24 hrs. Nat. _____

1st 24 hrs. after shot _____

Gas _____ Cu. Ft.

Dry Hole _____

Abandoned _____


Date

FEB 18 1952 19J. G. McGEHEE

Scout

O.W.W.O.

County Stafford State Kansas
 Sec. 4 (Blk. 23) (Sur. 12W) Map No. 1
 Operator Lowenstein et al. (was Trigg & Vernon)
 Well No. 1 Farm R. B. Dale (was Andrea)
 Elev. 1839 Location SE SE SE

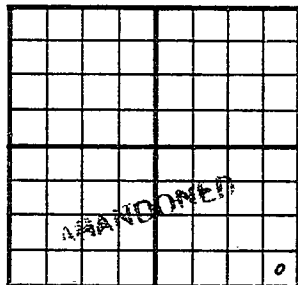

330 Ft. From S Line SE

330 Ft. From E Line Quarter

1st. Report

Completion FEB 25 1953

Remarks

OWWO

Spudding Date

O.W.W.O.

Drlg. Data D & A TD 3751

Lens. 3310 Cong. 3590 Viola 3617

Simp. 3635 Arb. 3693 OTD 3735

DD 3751 5" @ 3750 CO to 3724

6/ 3472-74 9/ 348-83 12/ 3632-36

8/ 3702-04 8/ 3708-10 16/ 3712-16

7/ 3718-20 500 A VSSO 2000 A

SP 3464 12/ 3457-60 500 A dry

SP 3360 20/ 3336-41 6/ 3351-53

D & A

J. G. McGEHEE