

Section 4 Township 23 Range 12WWell No. #1 DaleCompany B & R Drlg. Co.

NORTH

WEST

EAST

				0			

SOUTH

Stafford

✓ KANSAS

Sec. 4 Twp. 23 R. 12W

Well No. #1 Dale Farm

B & R Drlg. Co. Company

Contractor


Ft. from N. Line

330' Ft. from S. Line

Ft. from E. Line

330' Ft. from W. Line

SW SW SE

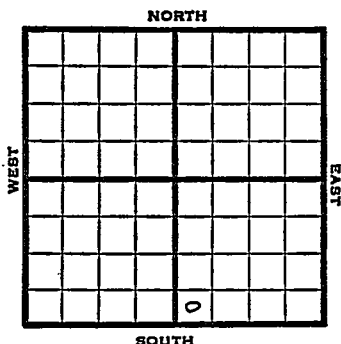

1951

Elev. 1842'

REPORT

6/20


7/11

Location

Spud 6-19-51 D & A TD 3772'
8" @203' Anhy 630' Lans. 3330'
Cong. 3612' Simp. 3675'
DST 3693-98' open 45 min. rec 45' mud
Arb. 3732-72' TD
D & A

ABANDONED

J. E. TYRA

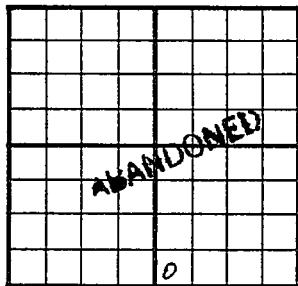County Stafford State KansasSec. 4 (Blk.
Twp.) 23 (Sur.
Rge.) 12W Map No.Operator B & R Drlg.Well No. 1 Farm DaleElev. 1842 Location SW SW SE330 Ft. From S Line SE330 Ft. From W Line QuarterIst. ReportCompletion JUL 11 1951RemarksSpudding Date 6-19-51Drlg. Data D & A TD 37328" @ 203 Anhy 630 Lans. 3330Cong. 3612 Simp. 3675 DST 3693-98open 45 min. Rec. 45' mudArb. 3732-72 TD. D & A

J. E. TYRA