

KANSAS


FORM 51 5M 1-42 PETROL

Stafford

Section 4 Township 23 Range 12 W

Well No. #1 Hall Anderea

Company Gulf

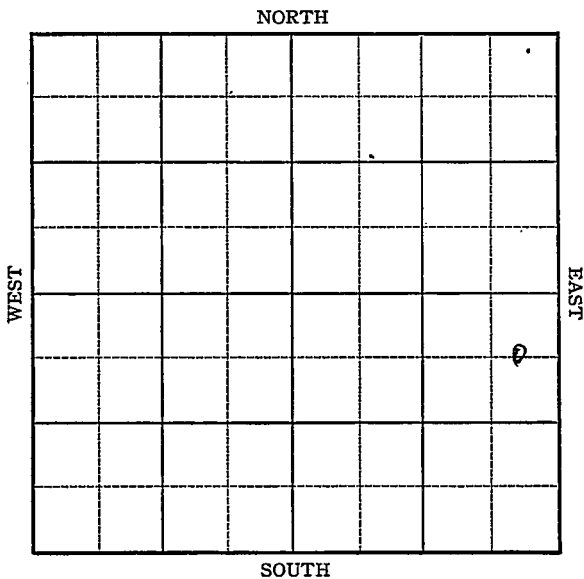

KANSAS

Stafford

Sec. 4 Twp. 23 R. 12-W

Well No. #1 Hall Anderea Farm

Gulf

Company

660

330

Ft. from N. Line


Ft. from S. Line

330

Ft. from E. Line

Ft. from W. Line

Wildcat

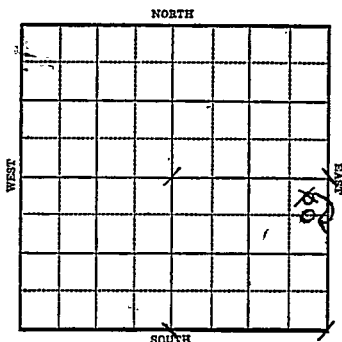

1943

elec. 1838 R E P O R T

7/28

Location

8/4

Rotary

8/11

8" @ 421 '
WOC.

8/18

Drlg. 2651'

8/25

3045' Fsg

9/1

" "

9/8

Drlg. 3155

9/15

Lans 3317
Viola 3606
Drlg. 3867

9/22

Miss 3606
Viola 3705
Arb 3776
T.D. 3898

ABANDONED

KANSAS**Stafford**Map No. 47 Sec. 4 Twp. 23 R. 12WWell No. 1 Hall AndereaGulf

Company

FIRST REPORT

Contractor

NE SE**SECTION PLAT**330 Ft. from N. Line Ft. from S. Line330 Ft. from E. Line Ft. from W. Line

			0

WILDCATLocation XXXRig up Drilling and Remarks: **RECORD**Cased in., ft.Sand Gas Oil Total Depth **PRODUCTION**1st 24 hrs. Nat. 1st 24 hrs. after shot Gas Cu. Ft.Dry Hole Abandoned

Date

JUL 28 1943 19S. J. LEWIS Scout

KANSAS

Stafford

Map No. 117 Sec. 4 Twp. 23 R. 12WWell No. 1 Hall Anderea

Gulf

Company

CORRECTION

Contractor

C EL NE SE

SECTION FLAT

660 Ft. from N. Line

			0

 Ft. from S. Line330 Ft. from E. Line Ft. from W. Line

WILDCA T

Location

RECORD

Rig up Cased in., ft.

Drilling and Remarks:

Sand Gas Oil

Reported

Total Depth

NE SE

PRODUCTION

1st 24 hrs. Nat. 1st 24 hrs. after shot Gas Cu. Ft.Dry Hole Abandoned

Date

AUG 4 1943 19S. J. LEWIS Scout

KANSAS

Map No. 47 Sec. 4 Twp. 23 R. 12WWell No. 1 Hall Anderes

Gulf

Company

ABANDONED

Contractor

C E L T E S E

SECTION FLAT

660 Ft. from N. Line

Ft. from S. Line

330 Ft. from E. Line

Ft. from W. Line

			2

Wildcat

Location

Rig up

Drilling and Remarks:

Miss 3606
Vista 3705
Per X 3776

RECORD

Cased _____ in., _____ ft.

Sand _____

Gas _____

Oil _____

Total Depth 3898

PRODUCTION

1st 24 hrs. Nat. _____

1st 24 hrs. after shot _____

Gas _____ Cu. Ft.

Dry Hole _____

Abandoned _____

Date

SEP 22 1943 19

S. J. LEWIS Scout