


DX 78-1

Stafford KANSAS

Section 4 Township 23 Range 13W
Well No. 1 Green
Company Welch & Olsson

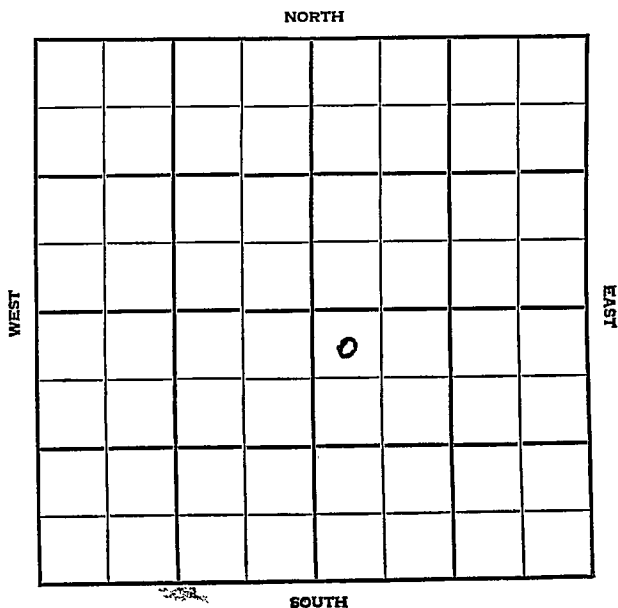

Stafford KANSAS

SEC.	TWP.	R.
4	23	13W

WELL NO.

1 Green

FARM

COMPANY

Welch & Olsson

CONTRACTOR

Co. Tools

Wildcat

330


Ft. from N. Line

Ft. from S. Line

Ft. from E. Line

330

Ft. from W. Line

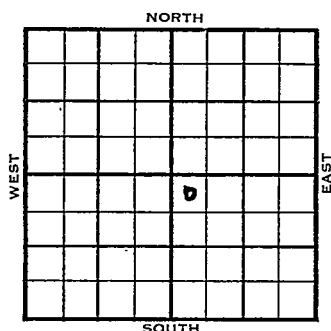

NW NW SE


	ELEVATION	REPORT
1954	1895'	

8/25 Drlg.
 10/13 Spud 8-25-54 - D&A
 TD 3865'
 8" @ 290'
 Heeb 3295', Tor 3312', Br lime 3430',
 Lans 3448'
 DST 3468-3500', opn $\frac{1}{2}$ hrs., rec. 22'
 mud, 750#
 DST 3589-3622', opn $\frac{1}{2}$ hrs., rec. 15'
 mud, 1160#
 Viola 3755', Simp. sh 3822', Simp sd
 3836', Arb. 3860'
 DST 3860-65', opn 1 hr., rec. 405'
 ho 860#
 TD 3865'
 5" @ 3861'
 CO to 3865'
 $3\frac{1}{2}$ boph 500A
 S/ $3\frac{1}{2}$ boph inc. to 7 boph
 P/5 bfph 75% wtr.
 D&A

ABANDONED

FABEN GILSTRAP

County Stafford State Kansas
 Sec. 4 (Blk.
Twp.) 23 (Sur.
Rge.) 13W Map No.
 Operator Welch & Olsson
 Well No. 1 Farm Green
 Elev. 1895 Location NW NW SE

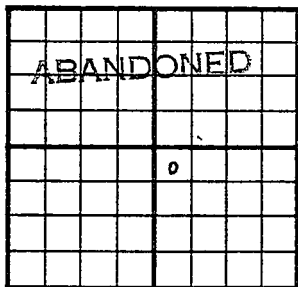

330 Ft. From N Line SE

330 Ft. From W Line Quarter

1st. Report

Completion OCT 13 1954

Remarks Wildcat

Co. tools

Spudding Date 8-25-54

Drig. Data D & A TD 3865

8" @ 290 Heeb. 3295 Tor. 3312

Br. lime 3430 Lans. 3448 DST 3468-3500

open $\frac{1}{2}$ hr. Rec. 22' mud 750#

DST 3589-3622 open $\frac{1}{2}$ hr. Rec. 15' mud

1160# Viola 3755 Simp. sh. 3822

Simp. sd. 3836 Arb. 3860 DST 3860-65

open 1 hr. Rec. 405' ho 860#

TD 3865 5" @ 3861 CO to 3865

$3\frac{1}{2}$ boph 500 A S/ $3\frac{1}{2}$ boph inc. to

7 boph P/ 5 bfph 75% wtr.

D & A

FABEN GILSTRUP