

Pawnee

DX 78-1

KANSAS
15W

Section 4 Township 23 Range 15W

Well No. #1 Grizzell

Company Max Cohen

NORTH

							0

WEST

EAST

SOUTH

Pawnee, Kansas

SEC.	TWP.	R.
4	23	15W

WELL NO.

1 Grizzell

FARM

COMPANY

Max Cohen

CONTRACTOR

Armer Tools

Unnamed Pool


330 _____ Ft. from N. Line

~~330~~ _____ Ft. from S. Line

330 _____ Ft. from E. Line

_____ Ft. from W. Line

NE NE SE

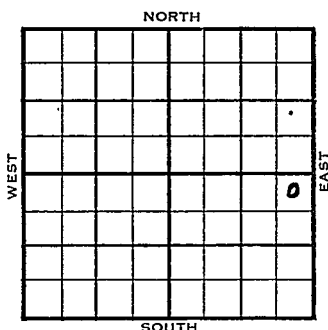

1954	ELEVATION	REPORT
	2007'	

9/29 Spud 9-27-54
8" @ 210'
Drlg. 1085'

11/23 Spud 9-27-54 - Oil Well
TD 4070'
8" @ 250'
Anhy 935', Heeb 3431', Tor 3468', Br.
lime 3553', Lans 3562', B KC 3787',
Cong. 3892', Viola 3915'
DST 3918-59', opn 1 hr., gas in 16",
rec. 90' mud, 925#
- Simp. 3993'
DST 3995-4028', opn 1 hr., rec. 15'
OCM, 0#
Arb. 4043'
TD 4070'
5" @ 4070'
CO, perf 4014-22, 48 shots, frac
S/5 boph
P/3 to 4 boph
omp. 238 bopd

COMPLETED

County **Pawnee** State **Kansas**

Sec. 4 (Blk. 23 (Sur. 15W Twp.) Rge.) Map No.

Operator **Max Cohen**

Well No. **1** Farm **Grizzell**

Elev.	Location	NE	NE	SE
-------	----------	----	----	----

0

FIRST REPORT

330 Ft. From N Line SE

330 Ft. From E Line Quarter

1st. Report **SFP 29 1954**

Completion _____

Remarks


Armer Tools

Spudding Date 9/27/54

Drlg. Data	Unnamed Pool
1	1
2	2
3	3
100	100

8th @ 210, Drlg 1085

FABEN GILSTRAP

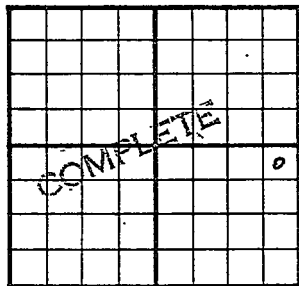County Pawnee State KansasSec. 4 (Blk.) 23 (Sur.) 15W Map No.Operator Max Cohen & M. B. ArmerWell No. 1 Farm GrizzellElev. 2007 Location NE NE SE330 Ft. From N Line SE330 Ft. From E Line Quarter1st. ReportCompletion NOV 23 1954Remarks Jay PoolArmer - Contr.Spudding Date 9-27-54Drlg. Data Oil well TD 40708" @ 250 Anhy 935 Heeb. 3431Tor. 3468 Br. lime 3553 Lans. 3562B KC 3787 Cong. 3892 Viola 3915DST 3918-59 open 1 hr. gas in 16 min.Rec. 90' mud 925# Simp. 3993DST 3995-4028 open 1 hr. Rec. 15' ocmO# Arb. 4043 TD 4070 5" @ 4070CO perf. 4014-22 48 shots fracS/ 5 boph P/ 3 to 4 bophComp. 238 bopd