


DX 78-1

Pawnee KANSAS

Section 4 Township 23 Range 16W

Well No. 1 Gilkison "A"

Company G-M-R Oil

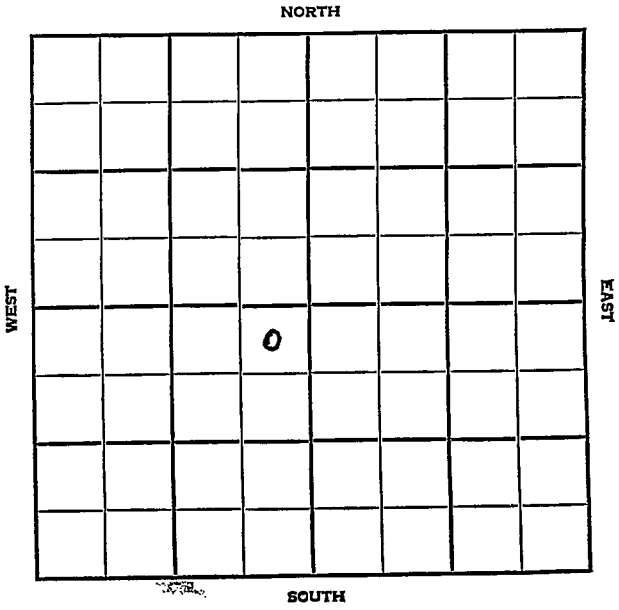

SEC: 4	TWP. 23	R. 16W
-----------	------------	-----------

WELL NO. #1 Gilkison "A" FARM

COMPANY G-M-R Oil

CONTRACTOR Co. Tools.

Wildcat.


330 Ft. from N. Line

Ft. from S. Line

330 Ft. from E. Line

Ft. from W. Line

NE NE SW

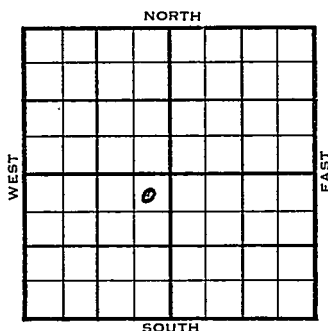

1954	ELEVATION	REPORT
	2052'	

9/1 Spud 8-28-54

8" @ 225'

Anhy 1028'

Drlg. 2216'

9/22 Spud 8-28-54

D & A

TD 4141'

8" @ 225'

Anhy 1028', Heeb 3529', Br. Lime 3643'

Lans 3651'

DST 3648'-71' opn 1 hr, rec 30' Mud 460#

DST 3682'-3700' opn 1 hr, rec 660' gas 60' so & gcm, 60' oil & gcmw, 200#

Cong 4042'

DST 4046'-74' opn 1½ hr, rec 20' Mud

0# Arb 4132'

DST 4107'-41' opn 1 hr, rec 1290' sw, 1300#

TD 4141'

5" @ 4141'

SP 3860 16/ 3840-44 16/ 3657-61

1000 A 3 bo 5 bw 3 hr. Tor 3542'

Cong 4010', Simp 4100'

D & A

ABANDONED

County Pawnee State Kansas

Sec. 4 (Blk.) 23 (Sur.) 16W Map No.

Operator G-M-R Oil

Well No. 1 Farm Gilkison "A"

Elev. 2052 Location NE NE SW

ABANDONED									

330 Ft. From N Line SW

330 Ft. From E Line Quarter

Ist. Report Sep 1 1954

Completion SEP 22 1954

Remarks

Co. Tools

Spudding Date 8-28-54

Drilg. Data D & A TD 4141 Wildcat

8" @ 225 Anhy 1028 Heeb. 3529

Br. lime 3643 Lans. 3651 DST 3648-71

open 1 hr. Rec. 30' mud 460#

DST 3682-3700 open 1 hr. Rec. 660' gas

60' so & gcm 60' oil & gcmw 200#

Cong. 4042 DST 4046-74 open 1 1/2 hr.

Rec. 20' mud 0# Arb. 4132 DST 4107-41

open 1 hr. Rec. 1290' sw 1300#

TD 4141 5" @ 4141 SP 3860 16/ 3840-44

16/ 3657-61 1000 A 3 bo 5 bw 3 hr.

Tor. 3642 Cong. 4010 Simp. 4100

D & A

FABEN GILSTRAP