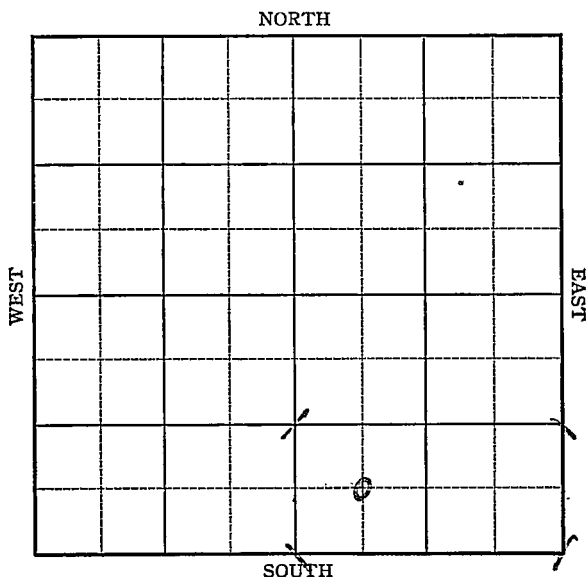


KANSAS

Pawnee

FORM 51 5M 4-41 PETROL

Section 4 Township 23 Range 16-WWell No. #1 Gilkison "B"Company StanolindWildcat


Map No. 84 Sec. 4 Twp. 23 R. 16WWell No. 1 Gilkison "B"Stanolind

Company

FIRST REPORT

Contractor

C SW SE

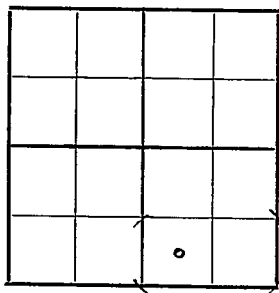SECTION PLAT Ft. from N. Line660 Ft. from S. Line Ft. from E. Line660 Ft. from W. Line**WILDCAT**Location Rig up

Drilling and Remarks:

Derrick**RECORD**Cased in., ft.Sand Gas Oil Total Depth **PRODUCTION**1st 24 hrs. Nat. 1st 24 hrs. after shot Gas Cu. Ft.Dry Hole Abandoned

Date

JUN 3 1942 19 S. J. LEWIS Scout

Pawnee

KANSAS

Map No. 84 Sec. 4 Twp. 23 R. 16WWell No. 1 Gilkison "B"

Stanolind

Company

ABANDONED

Contractor

C S W S E

SECTION PLAT

Ft. from N. Line

660 Ft. from S. Line

Ft. from E. Line

660 Ft. from W. Line

VILDCAT

Location _____

Rig up _____

Drilling and Remarks:

Comp 4005
Per 4165
Noe hrs

RECORD

Cased _____ in., _____ ft.

Sand _____

Gas _____

Oil _____

Total Depth 4260

PRODUCTION

1st 24 hrs. Nat. _____

1st 24 hrs. after shot _____

Gas _____ Cu. Ft.

Dry Hole _____

Abandoned _____

Date

JUL 1 1942 19 S. J. LEWIS Scout