

Pawnee


DX 78-1

KANSAS

Section 4 Township 23 Range 17W

Well No. #1 V. Davis

Company Sunray

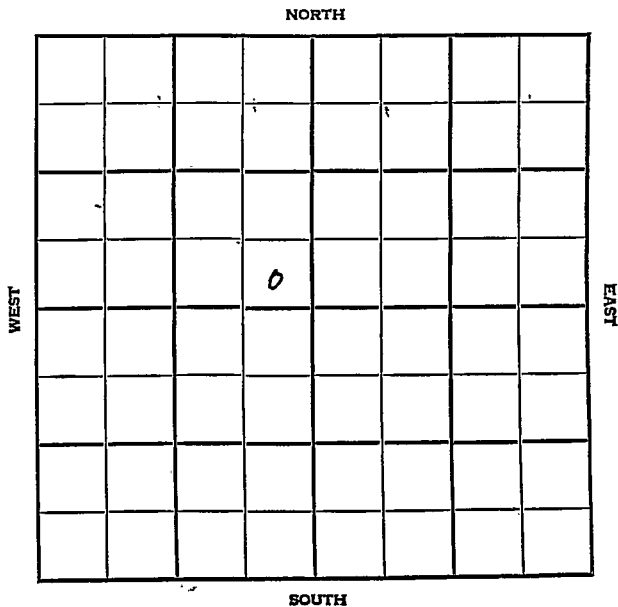

Pawnee KANSAS

SEC.	TWP.	R.
4	23	17W

WELL NO.

1 V. Davis

FARM

COMPANY

Sunray

CONTRACTOR

Stickle

Garfield Pool -


_____ Ft. from N. Line

330 _____ Ft. from S. Line

330 _____ Ft. from E. Line

_____ Ft. from W. Line

SE SE NW

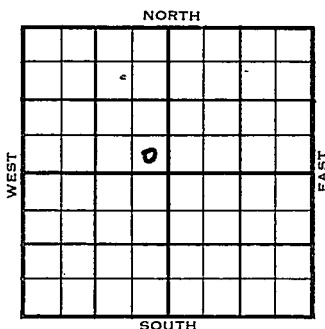

1955	ELEVATION	REPORT
	2059'	

3/2

Spud 2-26-55
8" @ 291'

4/13

Spud 2-26-55 - Oil Well
TD 4280'
8" @ 291'
Heeb. 3606' $\frac{1}{2}$ Br lime 3706', L ans 3714'
B KC 3989', Cherokee 4118', Cherokee
sd 4130', Ch Cong. 4140'
DST 4191-4206', opn 1 hr., rec. 100'
mud, 185#
DST 4205-40', opn 1 hr., rec. 120'
gas, 185' vso&gem, 205#
Viola 4260'
TD 4280'
5" @ 4275'
CO to 4233'
16/4206-10, 5 gw $\frac{1}{2}$ hrs., 4 gw 2nd
 $\frac{1}{2}$ hrs., 1 gw 3rd $\frac{1}{2}$ hr.,
16/4206-10, 5 gw $\frac{1}{2}$ hr., 4 gw 1 go
2nd $\frac{1}{2}$ hrs., 1 $\frac{1}{2}$ go 3rd $\frac{1}{2}$ hrs., 250 M-A
visco-frac, 1/68 bfph 50% wtr.
32/4192-4200, 16/4184-88, 2 gw $\frac{1}{2}$ hrs.,
1 gw $\frac{1}{2}$ hrs., 2 50A, frac, SP 4170

OVER

(Information Brought Forward)

1955
4/13

16/4158-62, 1 bo 3 hrs., 12/4155-58,
1 bo 4 hr., 250A, frac
S/8.8 boph
P&F 6 bo 15"
P&F 6 bo .8 hrs.
P&F 10 bo
Comp. 266 bopd

COMPLETED

Orig. Data

16/ 4158-62 1 bo 3 hr. 12/ 4155-58

1 bo 4 hr. ~~250 A frag~~ S/ 8.8 boph

P & F/ 6 bo 15 min. P & F/ .6 bo 8 hr.

P & F/ 10 bo Comp. 266 boph

Scout Cards
Land Small Map
Land Wall Map
Tracing
France Map

APR 20 1955