


Section 4 Township 23 Range 17 W

Well No. #3 Ewing

Company Clark Knight

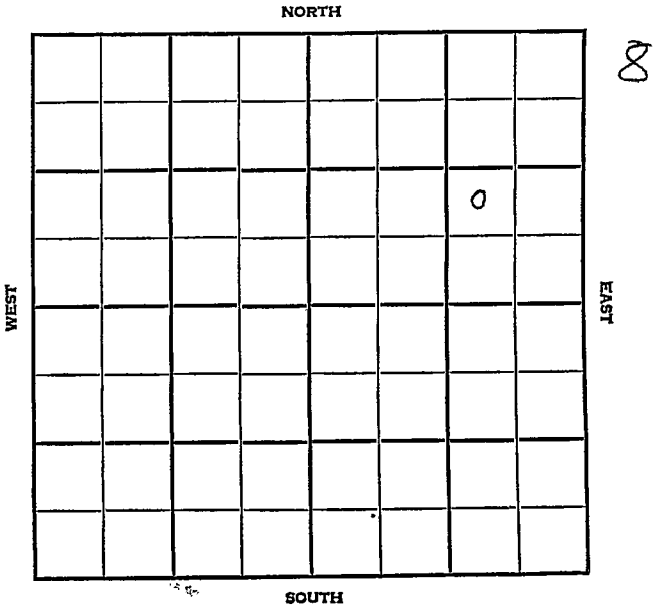

SEC.	TWP.	R.
4	23	17W

WELL NO.

#3 Ewing

FARM

COMPANY

Clark Knight

CONTRACTOR

Co. Tools

Garfield


Ft. from N. Line

Ft. from S. Line

Ft. from E. Line

Ft. from W. Line

NW SE NE

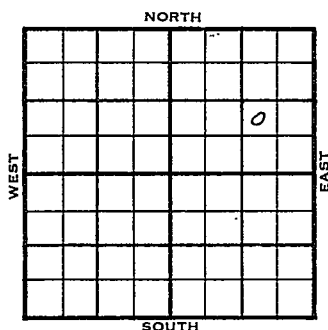

1956

ELEVATION

2056

REPORT

2-29

Comm. 2-28-56

10" @ 170/150

WOC

4-4

DST 4103-22 op 1 hr. gas in 2 min.
 1800 mcfg 3 min, rec. 240' gcm,
 1095/20"

DST 4134-60 op 1 hr. gas in 3 min,
 F/ oil in 20 min, rec. 540' oil,
 1095/20"

5½" @ 4243/225

CO to 4190

18/ 4156-62, 11/ 4167-71,

FU 1500' oil, 21 hrs., 250 A

Frac.

F/ 25 bpph 6 hr.

Comp. F/ 306 bopd.

Anh. 1085

M. 4192

H. 3581

K. 4222

Tr. 3597

V. 4230

BL 3688

TD 4245

L. 3695

BKC 3974

Ce. sh. 4105


C. Sa. 4112

Cg. 4125

COMPLETED

County Pawnee Elev. _____
 Sec. 4 Twp. 23 Rge. 17W
 Company Clark Knight
 Farm Name Ewing No. 3

TOPS	DEPTH	LOG	DATUM	Loc. in Sec.
Anh.				NW SE NE
Tr.				
H.				
Tr.				
Dg.				
Bl.				
L.				
K.C.				Geol.
B.K.C.				Gentr.
Ce.				Co. tools
C.				
M.				
M.				
K.				
Mz.				Garfield
Mo.				
V.				
S.				
S.				
A.				
R.				
Pe.				FIRST REPORT
G.				
TD.				FEB 29 56

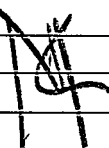Date Comm. 2-28-56
10" @ 170/150 WOC


County Parmer Elev. 2056
 Sec. 4 Twp. 23 Rge. 17W
 Company Clark Knight
 Farm Name Hwing No. 3

TOPS	DEPTH	LOG	DATUM
Anh.	1085		
TP.			
H.	3581		
Tr.	3597		
Dg.			
BL.	3688		1632
L.	3695		1639
K.C.			
B.K.C.	3974		1918
Ce.	4105		2049
C.	4112		2056
M.	4125		2069
M.	4192		2136
K.	4222		2166
Mz.			
Mq.			
V.	4230		2174
S.			
S.			
A.			
R.			
PE.			
G.			
T.D.	4245		

Loc. in Sec.

NW SE NE

Geol.

Contr.

Co. tools

Pool

Garfield

COMPLETE

APR 4 '59

Date Comm. 2-28-56

10" @ 170/150 DST 4103-22 open 1 hr.

gas in 2 min. 1,800 mcfg 3 min.

rec. 240' gcm 1095/20" DST 4134-60

open 1 hr. gas in 3 min. F/ oil in

20 min. rec. 540' oil 1095/20"

5 $\frac{1}{2}$ " @ 4243/225 GO to 4190

18/ 4156-62 11/ 4167-71 FU 1500' oil

12 hr. 250 A frac F/ 25 boph 6 hr.

Comp. F. 306 bopd