


Section 4 Township 23 Range 17W

Well No. 1 Titus

Company Drillers Explor., Inc.

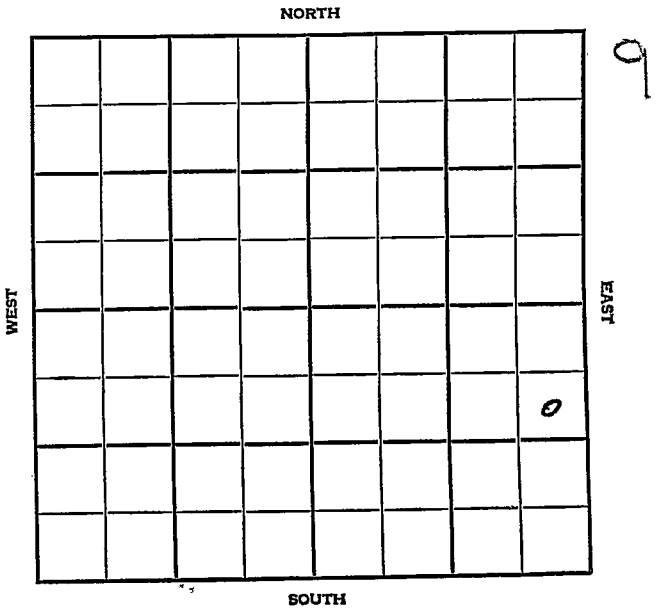

Pawnee KANSAS

SEC. 4	TWP. 23	R. 17W
-----------	------------	-----------

WELL NO. 1 Titus FARM

COMPANY Drillers Explor., Inc.

CONTRACTOR


Garfield Pool

990 Ft. from N. Line

Ft. from S. Line

330 Ft. from E. Line

Ft. from W. Line

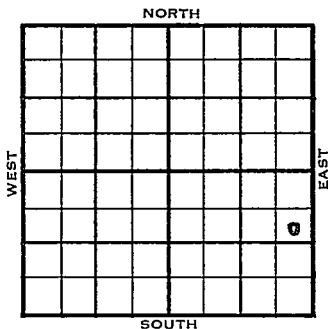

SE NE SE

ELEVATION

REPORT

1955

2/23

Location

