


Section 4 Township 23 Range 17W
Well No. 2 Titus
Company Drilling & Exploration Co., Inc.

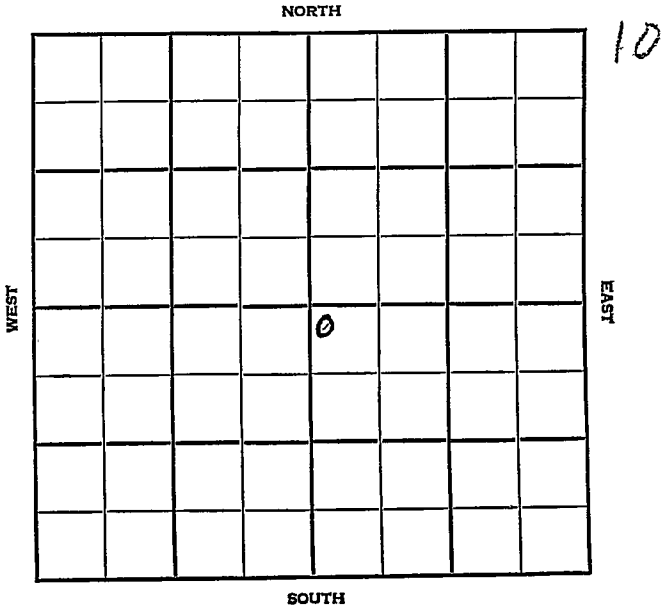

Pawnee

KANSAS


SEC.	TWP.	R.
4	23	17W

WELL NO. 2 Titus FARM

COMPANY Drilling & Exploration Co., Inc.

CONTRACTOR B & B Drlg.
Garfield

_____ Ft. from N. Line
_____ Ft. from S. Line
_____ Ft. from E. Line
_____ Ft. from W. Line

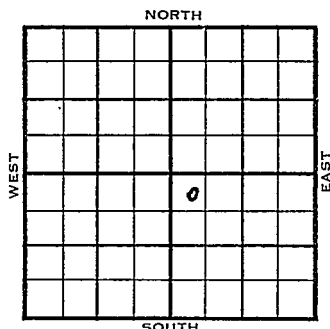

NW NW SE

Offset = SDX

	ELEVATION	REPORT
1955	2061'	
6/15	Comm 6-9-55 8" @ 260/225 Drlg 2639 Anh 1190	
6/23	Shaley Cong. 4122', Cong chert 4151' Drlg. 4220'	
6/30	5 1/2" @ 4263,150, CO to 4229, TD 4266, 8 1/4/4156-70, FU 2185' oil, 8 hr. 200 A, frac, F/35 boph, 2 hr.	
7/7	Shut in for tanks.	
7/13	Comm. 6-9-55 8" @ 260 w/225 5 1/2" @ 4253 CO to 4229 8 1/4/4156-70 FU 2185' oil 8 hrs. 200 A frac. F/35 BOPH 2 hr. Comp. BHB 2019 BOPD Anh. 1190', H. 3596', BL 3710', L. 3719', C. Sh 4122', Cong ch 4151' TD 4266'	

COMPLETED

County Pawnee Elev. _____
 Sec. 4 Twp. 23 Rge. 17W
 Company Drilling & Exploration Co., Inc.
 Farm Name Titus No. 2

TOPS	DEPTH	LOG	DATUM	Loc. in Sec. _____
Anh.	1190			NW NW SE
Tr.				
H.				
Tr.				
Dg.				
BL.				
L.				Geol. _____
K.C.				Contr. _____
B.K.C.				
Ce.				R & B Drllg.
C.				Pool
M.				<u>Garfield</u>
M.				
K.				
Mz.				
Ma.				
V.				
S.				
S.				
A.				
R.				
Pe.				
G.				
T.D.				

Date Comm. 6-9-55

8" @ 260/225 drlg. 2639

K-44

County Pawnee Elev. 2061
 Sec. 4 Twp. 23 Rge. 17W
 Company Drilling & Exploration Inc.
 Farm Name Titus No. 2

TOPS	DEPTH	LOG	DATUM	Loc. in Sec.
Anh.	1190			NW NW SE
TP.				
H.	3596		1585	
Tr.				
Dg.				
BL.	3710		1649	
L.	3719		1658	
K.C.				Geol.
B.K.C.				Contr.
Ce.				
C. <i>Sh</i>	4122		2061	B. & B
M. <i>Cong. sh</i>	4151		2090	
M.				Pool
K.				Garfield
Mz.				
Mq.				
V.				
S.				
S.				
A.				
R.				
PE.				
G.	PF		2095-709	
	53		2192	
T.D.	4266		2205	

Date Comm. 669-55 JUL 13 1955
8" @ 260/225 5 $\frac{1}{2}$ " @ 4253 CO to 4229
84/ 4156-70 FU 2185' oil 8 hr1
200 A frac F/ 35, boph 2 hr.
 Comp. BHB 2019 bopd