


Section 4 Township 23 Range 17 W

Well No. #2 Welch

Company Rooney-Siegfried & Thomas

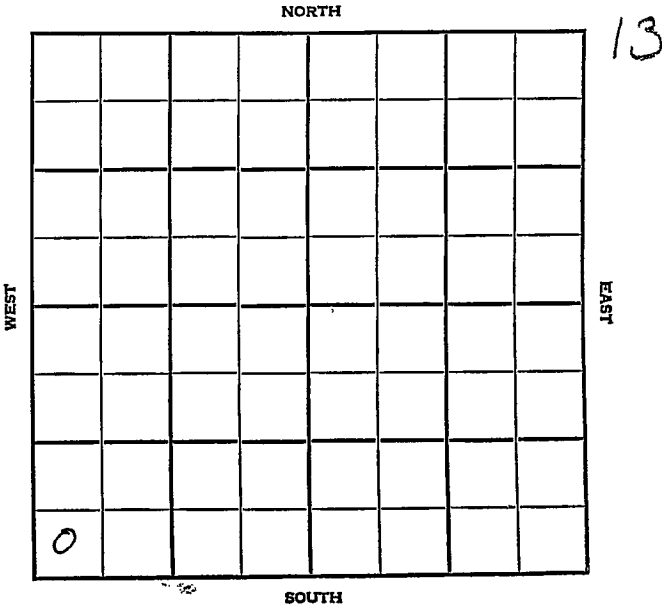



County Permee Elev. 2047  
 Sec. 11 Twp. 23 Rge. 17W  
 Company Rooney-Siegfried & Thomas  
 FarmName Welch No. 2

TOPS	DEPTH	LOG	DATUM
Anh.	1075		
TP.			
H.			
Tr.			
Dg.			
BL.			
L.			
K.C.			
B.K.C.			
Ce.			
C.			
M.			
M.			
K.			
Mz.			
Me.			
V.			
S.			
S.			
A.			
R.			
PE.			
G.			
TD.			

Loc. in Sec. SW SW SW

Geol. \_\_\_\_\_

Contr. \_\_\_\_\_

Jayhawk

Pool

Garfield

FIRST REPORT  
 AUG 17 '55

Date Comm. 8-7-55  
8" @ 255/225 drlg. 3691

14

Co.

Lse.

No.

Sec.

T.

R.

County Patnee Elev. 2067  
 Sec. 11 Twp. 23 Rge. 17W  
 Company Rooney-Siegfried & Thomas  
 Farm Name Welch No. 2

TOPS	DEPTH	LOG	DATUM	Loc. in Sec.
Anh.	<u>1075</u>			SW SW SW
TP.				
H.	<u>3611</u>		<u>1544</u>	
Tr.				
Dg.				
Bl.	<u>3716</u>		<u>1649</u>	
L.	<u>3724</u>		<u>1657</u>	Geol.
K.C.				
B.K.C.				Contr.
Ce.				
C. <u>shls</u>	<u>4141</u>		<u>2074</u>	Jayhawk
M. <u>Comp. fid</u>	<u>4163</u>		<u>2096</u>	
M. <u>Comp. ch</u>	<u>4172</u>		<u>2105</u>	Pool
K.				
Mz.				Garfield
Me.				
V.				
S.				
S.				
A.				
R.				
PE.				
G.				
T.D.	<u>4309</u>			

**COMPLETE**

Date Comm. 8-7-55 **OCT 5 1955**  
8" @ 255/225 5 1/2" @ 1308 DST 1168-88  
 open 1/2 hr. gas to surface in 1 min.  
1,930 mcfg in 5 min. S./oil in 23 min.  
1190# DST 1196-1213 open 1/2 hr.  
 Rec. 20' mud 0# GO to 1291 18/ 1181-  
92 500 A F/ 11 boph frac  
 F/ 53 boph 2 hr. Comp. F/ 1724 bopd

Co.  
 Use.  
 No.  
 Sec.  
 T.  
 R.