


Section 4 Township 23 Range 22WWell No. #1 BaldreyCompany K. E. Ellison

NORTH

WEST

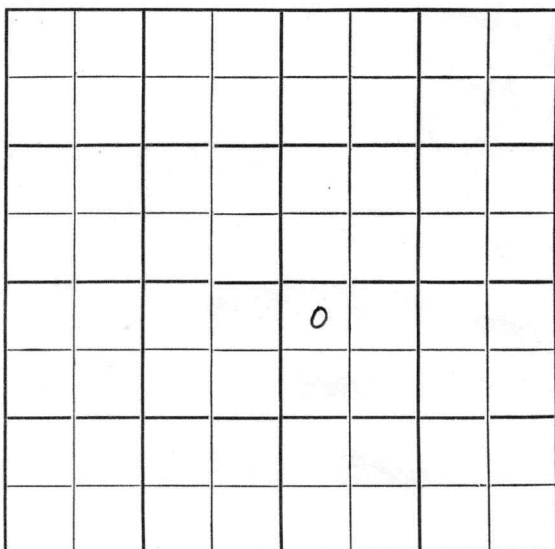

EAST

SOUTH

Sec. 4 Twp. 23 R. 22 W

Well No. # 1 Baldrey Farm

K. E. Ellison Company

Contractor

Wildcat


330 Ft. from N. Line

_____ Ft. from S. Line

_____ Ft. from E. Line

330 Ft. from W. Line

NW NW SE

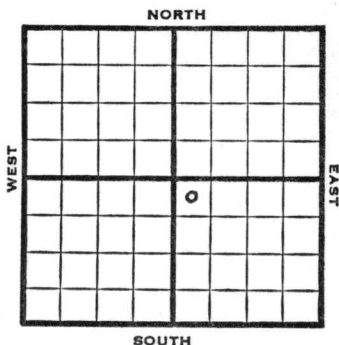

1952

Elev. 2189' REPORT

1/2 Spud 12-29-51
Drilling

1/23 Spud 12-29-51
D&A TD 4490
10" @ 305 8" @ 1050
KC 3785 Heeb. 3763 KC 3829
Lans. 3807 Miss. 4438
TD 4490 D&A

ABANDONED

County Hodgeman State KansasSec. 4 (Blk.) 23 (Sur.) 22W Map No.Operator K. E. EllisonWell No. 1 Farm BaldreyElev. Location NW NW SE

FIRST REPORT

330 Ft. From N Line SE330 Ft. From W Line Quarter1st. Report JAN 2 1952

Completion

Remarks

Spudding Date 12-29-51Drlg. Data Wildcatdrlg.


J. E. TYRA

County Hodgeman State Kansas
 Sec. 4 (Blk. 23 (Sur. 22W Map No.

Operator K. E. Ellison

Well No. 1 Farm Baldrey

Elev. 2189 Location NW NW SE

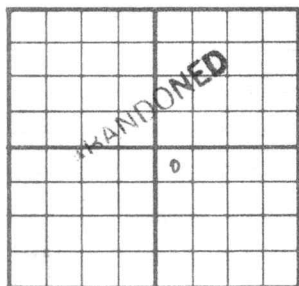

330 Ft. From N Line SE

330 Ft. From W Line Quarter

1st. Report

Completion JAN 23 1952

Remarks Wildcat

Spudding Date 12-29-51

Drlg. Data D & A TD 4490

10" @ 305 8" @ 1050 KC 3785

Heeb. 3763 KC 3829 Lans. 3807

Miss. 4438 TD 4490

D & A