

Hodgeman

DX 78-1


KANSAS
24W

Section 4 Township 23 Range 24W

Well No. #1 Eichman "C"

Company Trans-Era & I.W. Seigel

NORTH

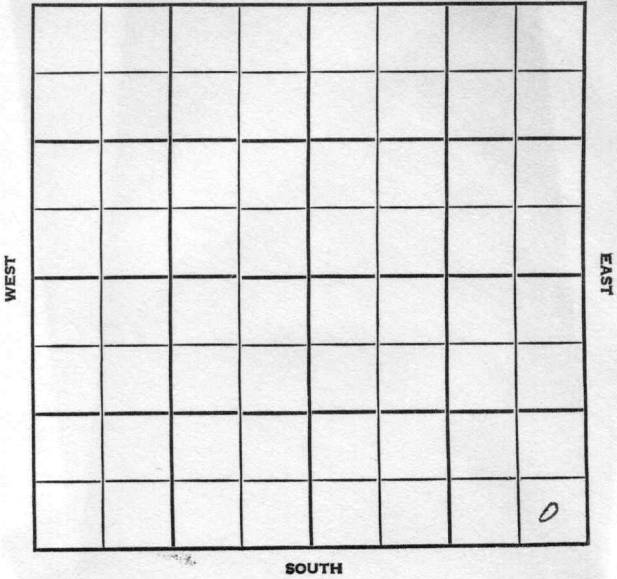

Hodgeman KANSAS

SEC.	TWP.	R.
4	23	24W

WELL NO.

1 Eichman "C"

FARM

COMPANY

Trans-Era & I. W. Seigel

CONTRACTOR

Trans-Era


Wildcat

_____ Ft. from N. Line

330 _____ Ft. from S. Line

330 _____ Ft. from E. Line

_____ Ft. from W. Line

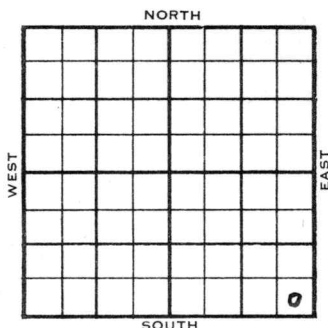

SE SE SE

Northern Nat. FO

	ELEVATION	REPORT
1955	2297'	

1/19 Spud 1-13-55
8" @ 216'
Anhy 1825'
Drlg. 2900'

2/2 Spud 1-13-55 - D&A
TD 4562'
8" @ 216'
Anhy 1825', Heeb. 3833', Br lime
3882', Lans. 3910', Cong. 4530', Ch.
Cong. 4542', Miss 4557'
DST 4552-62', opn 1½ hrs., rec. 90'
SOCMW, 625#
TD 4562'
D&A

ABANDONED

County Hodgeman State Kansas

Sec. **4** (Blk.) **23** (Sur.) **24W** Map No.

Operator Trans-Era & I. W. Seigel

Well No. **1** Farm **Eichman "C"**

Elev.	Location	SE SE SE

FIRST REPORT

330 Ft. From S Line SE

330 Ft. From E Line Quarter

1st. Report JAN 19 1955

Completion _____

Remarks Northern Nat. farmout

Trans-Era - Contr.


Spudding Date 1-13-55

Drig. Data Wildcat

8" @ 216 Anhy. 1825 drlg. 2900

FABEN GILSTRAP

County Hodgeman State Kansas
 Sec. 4 (Blk. 23 (Sur. 24W Map No.
 (Twp.) (Rge.)
 Operator Trans-Era & I. W. Seigel
 Well No. 1 Farm Eichman "C"
 Elev. 2297 Location SE SE SE

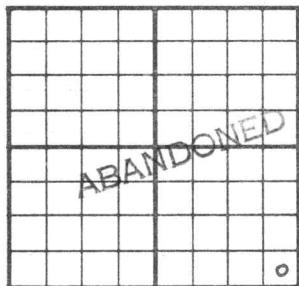

330 Ft. From S Line SE
330 Ft. From E Line Quarter
 1st. Report
 Completion FEB 2 1955
 Remarks Wildcat
Trans-Era - Contr.
 Spudding Date 1-13-55

Drlg. Data D & A TD 4562
8" @ 216 Anhy 1825 Heeb. 3833
Br. lime 3882 Lans. 3910 Cong. 4530
Ch. Cong. 4542 Miss. 4557 DST 4552-62
open $1\frac{1}{2}$ hr. Rec. 90' socmww 625#
TD 4562

D & A

FABEN GILSTRA