


Section 4 Township 23 Range 33W

Well No. #1 Garry

Company W. L. Hartman

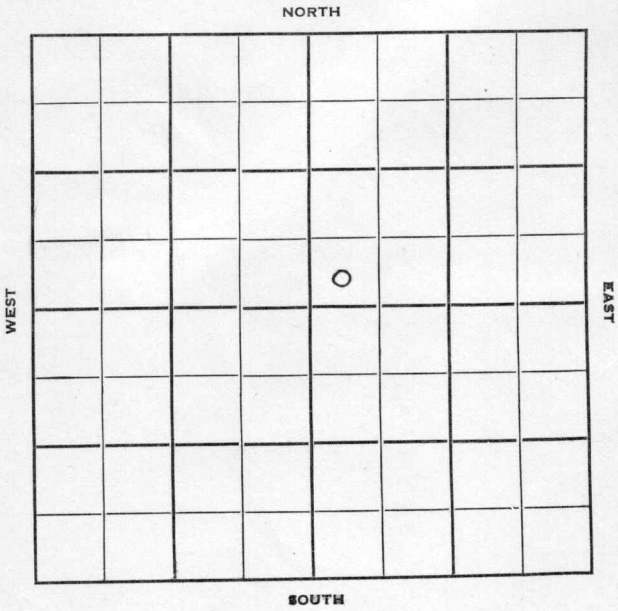

Sec. 4 Twp. 23 R. 33W

Well No. #1 Garry Farm

W. L. Hartman Company

Contractor

Hugoton Pool

Ft. from N. Line

330


Ft. from S. Line

Ft. from E. Line

330

Ft. from W. Line

SW SW NE

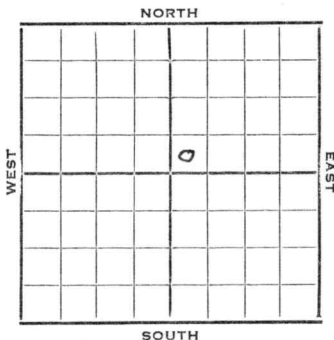

1952

Elev. 2883'

REPORT

9/24

10" @ 318'

Hol. 2489

Her. 2515

Kri. 2534

Win. 2569

Drlg. 2600'

10/1

Odell 2552

Gauge 2603

Up Ft. 2631

Low Ft. 2685

RTD 2705 7" @ 2705'

10/8

"

10/15

52/2591-2604, 60/2538-53, 84/2520-34,  
120/2571-91, 8000A

10/22

22,000 A

10/29

Gas Well TD 2705' 10" @ 318'

Hol. 2489

Her. 2552

Kri. 2534

Win. 2569

Odell 2552

Ft. Riley 2631

TD 2705 7" @ 2705

52/ 2591-2604

60/ 2538-53

84/ 2520-34

120/ 2571-91

22000 A

Comp. 24,000,000 gas

**COMPLETED**



