

KANSAS

FORM 51 5M 10-41 PETROL


Hodgeman

Section 4 Township 23 Range 22-W

Well No. #1 Baldey

Company Fain Drilling

Wildcat

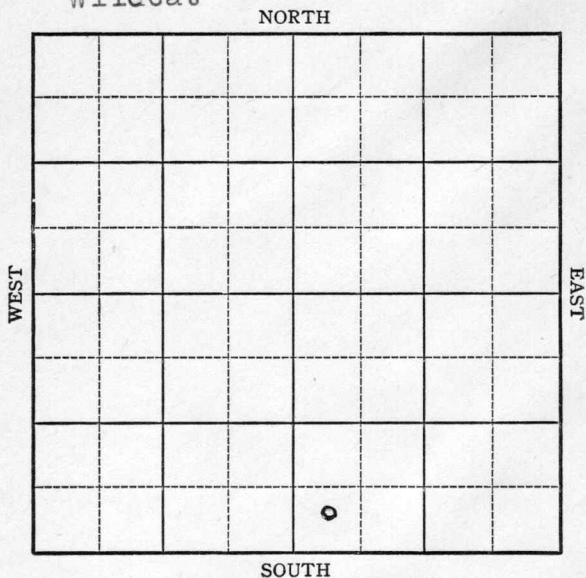

KANSAS

Hodgeman

Sec. 4 Twp. 23 R. 22W

Well No. #1 Baldey Farm

Fain Drilling Company

(Wildcat)


 Ft. from N. Line

330 Ft. from S. Line

 Ft. from E. Line

330 Ft. from W. Line

Elev. 2216

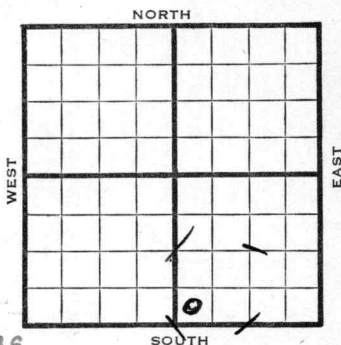

1942

REPORT

8/5	20' of 10"
	Shut down
	Stanolind Farm out.
8/12	" " "
8/19	" " "
8/27	" " "
9/2	" " "
9/9	" " "
9/16	Abandoned location

ABANDONED

Hodgeman

KANSAS

Map No. 86 Sec. 4 Twp. 23 R. 22WWell No. 1 BaldeyFain Drilling


Company

FIRST REPORT

Contractor

SW SE

SECTION PLAT

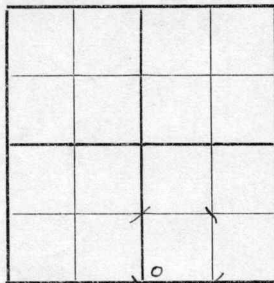

_____ Ft. from N. Line

330 Ft. from S. Line

_____ Ft. from E. Line

330 Ft. from W. Line**WILDCAT**

Location _____

Rig up _____

Drilling and Remarks:

20' of 10"Shut DownStanford Farm
day

RECORD

Cased _____ in., _____ ft.

Sand _____

Gas _____

Oil _____

Total Depth _____

PRODUCTION

1st 24 hrs. Nat. _____

1st 24 hrs. after shot _____

Gas _____ Cu. Ft.

Dry Hole _____

Abandoned _____

Date

AUG 5 194219S. J. LEWISScout

Hodgeman

KANSAS

Map No. 86 Sec. 4 Twp. 23 R. 22WWell No. 1 Baldry

Fain Drilling

Company

ABANDONED

Contractor

SW SE

SECTION PLAT

		0	

Ft. from N. Line

330

Ft. from S. Line

Ft. from E. Line

330

Ft. from W. Line

WILDCAT

Location ✓

Rig up _____

Drilling and Remarks:

RECORD

Cased _____ in., _____ ft.

Sand _____

Gas _____

Oil _____

Total Depth _____

PRODUCTION

1st 24 hrs. Nat. _____

1st 24 hrs. after shot _____

Gas _____ Cu. Ft.

Dry Hole _____

Abandoned _____

Date

SEP 16 1942

19

S. J. LEWIS

Scout