


Section 4 Township 23 Range 35W

Well No. #1 Miller "B"

Company Stanolind

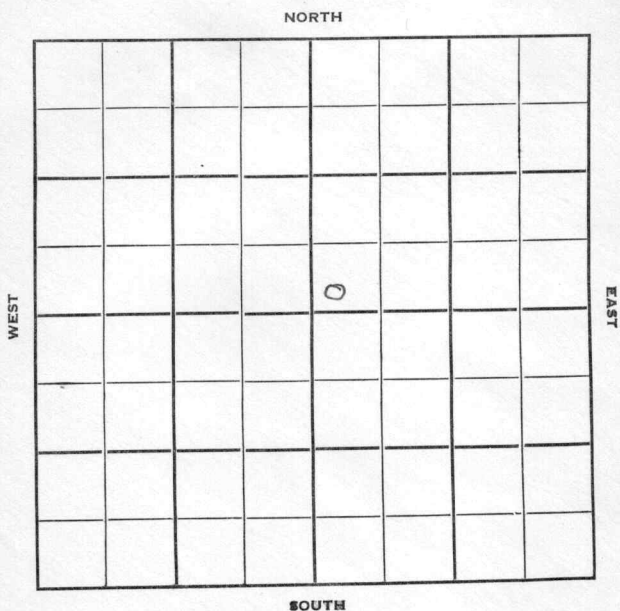

Kearny

KANSAS

Sec. 4 Twp. 23 R. 35 W

Well No. # 1 Miller "B" Farm

Stanolind Company

Contractor

Ft. from N. Line

150


Ft. from S. Line

Ft. from E. Line

150

Ft. from W. Line

SW NE

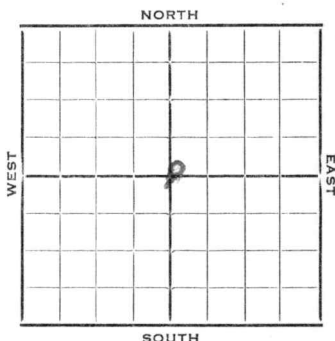

1952

Elev. 3045' REPORT

11/5

Location

11/12

Her 2554' TD 2568'

11/20

7" @ 2554'

11/27

NR

12/3

Spud 11-2-52

Gas Well

TD 2629'

10" @ 865

Her. 2554, Kri. 2570, Win.

2606

7" @ 2554

TD 2629

155 qt/2574-2606 CO to 2629

Comp. 4,000,000 gas

COMPLETED

County Kearny State KansasSec. 4 (Blk.) 23 (Sur.) 3 5W (Twp.) Map No.Operator StanolindWell No. 1 Farm Miller "B"Elev. _____ Location SW NE

0

FIRST REPORT

150 Ft. From S Line NE150 Ft. From W Line Quarter1st. Report NOV 5 1952

Completion _____


Remarks _____

Spudding Date _____

Drlg. Data _____

Location

J. G. McGEHEE

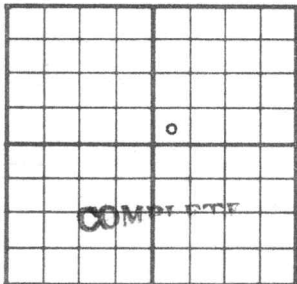County Kearny State KansasSec. 4 (Blk. Twp.) 23 (Sur. Rge.) 35W Map No.Operator StanolindWell No. 1 Farm Miller "B"Elev. 3045 Location SW NE150 Ft. From S Line NE150 Ft. From W Line Quarter

1st. Report

Completion DEC 3 1952

Remarks

Spudding Date 11-2-52Drlg. Data Gas well TD 262910" @ 865 Her. 2554 Kri. 2570Win. 2606 7" @ 2554 TD 2629155 qt/ 2574-2606 CO to 2629Comp. 4,000,000 gas

J. G. McGEHEE