

15-075-20232

State Geological Survey
KANSAS DRILLERS LOG BRANCH

API No. 15 — 075 — 20,332
County Number

S. 20 T. 23 R. 40 ^{*}W
Loc. C SE NW
County Hamilton

Operator
Ladd Petroleum Corp.

Address
830 Denver Club Bldg. Denver, Colo 80202


Well No. #2030-B Lease Name HCU

Footage Location
1980 feet from (N) line 1980 feet from (W) line

Principal Contractor MID AMERICA Geologist NONE

Spud Date 5/11/79 Total Depth 2600' P.B.T.D. 2567'

Date Completed 6/5/79 Oil Purchaser NONE

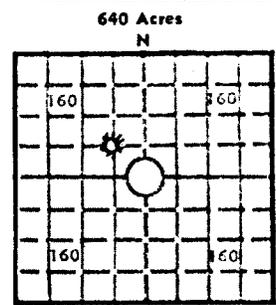

Elev.: Gr. 3412
DF - KB 3420

CASING RECORD

Report of all strings set — surface, intermediate, production, etc.

Purpose of string	Size hole drilled	Size casing set (in O.D.)	Weight lbs/ft.	Setting depth	Type cement	Sacks	Type and percent additives
SURFACE	12 1/4	8 5/8	28 #	260'	H	175	3% CaCl
PRODUCTION	7 7/8	4 1/2	10.5 #	2599'	H	400	4 1/4% GEL
					50-50 POZ	150	18% SALT

LINER RECORD

PERFORATION RECORD

Top, ft.	Bottom, ft.	Sacks cement	Shots per ft.	Size & type	Depth interval
-	-	-	25 SPF	1/2 JET	2517-2523'

TUBING RECORD

Size	Setting depth	Packer set at
2 3/8	2511	NONE

ACID, FRACTURE, SHOT, CEMENT SQUEEZE RECORD

Amount and kind of material used	Depth interval treated
500 GALS 15% X ACID	2517-2523'
1500 GALS 15% CRA ACID	2517-2523'

INITIAL PRODUCTION

Date of first production 6/5/79 Producing method (flowing, pumping, gas lift, etc.) FLOWING

RATE OF PRODUCTION PER 24 HOURS
Oil — bbls. Gas 190 MCF Water — bbls. Gas-oil ratio — CFPB

Disposition of gas (vented, used on lease or sold) SOLD Producing interval (s) 2517-2523'

INSTRUCTIONS: As provided in KCC Rule 82-2-125, within 90 days after completion of a well, one completed copy of this Drillers Log shall be transmitted to the State Geological Survey of Kansas, 4150 Monroe Street, Wichita, Kansas 67209. Copies of this form are available from the Conservation Division, State Corporation Commission, 3830 So. Meridian (P.O. Box 17027), Wichita, Kansas 66217. Phone AC 316-522-2206. If confidential custody is desired, please note Rule 82-2-125. Drillers Logs will be on open file in the Oil and Gas Division, State Geological Survey of Kansas, Lawrence, Kansas 66044.

erator

DESIGNATE TYPE OF COMP.: OIL, GAS, DRY HOLE, SWDW, ETC.:

LADD PETROLEUM

Well No. 2030-B

Lease Name HCU

GAS

S21 T23 R90 W

WELL LOG

Show all important zones of porosity and contents thereof; cored intervals, and all drill-stem tests, including depth interval tested, cushion used, time tool open, flowing and shut-in pressures, and recoveries.

SHOW GEOLOGICAL MARKERS, LOGS RUN, OR OTHER DESCRIPTIVE INFORMATION.

FORMATION DESCRIPTION, CONTENTS, ETC.	TOP	BOTTOM	NAME	DEPTH
			GR-NEUTRON	2567-1000'

USE ADDITIONAL SHEETS, IF NECESSARY, TO COMPLETE WELL RECORD.

Date Received

[Handwritten Signature]

Signature

PRODUCTION ENGINEER

Title

7/11/79

Date