


Section 5 Township 23 Range 3W

Well No. #5 Vogt

Company Gilcrease Oil

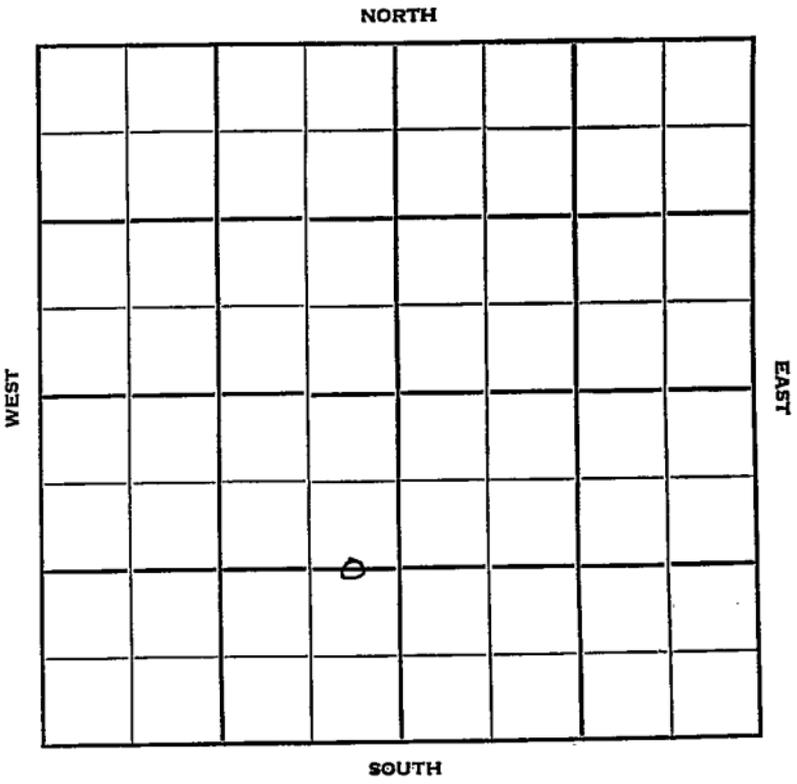

Harvey

KANSAS

3W

Sec. 5 Twp. 23 R. 3W

Well No. #5 Vogt Farm

Gilcrease Oil Company

Carey Drlg. - Contr. Contractor

Burttn Pool


1320' Ft. from N. Line

Ft. from S. Line

330' Ft. from E. Line

Ft. from W. Line

G E L E $\frac{1}{2}$ SW

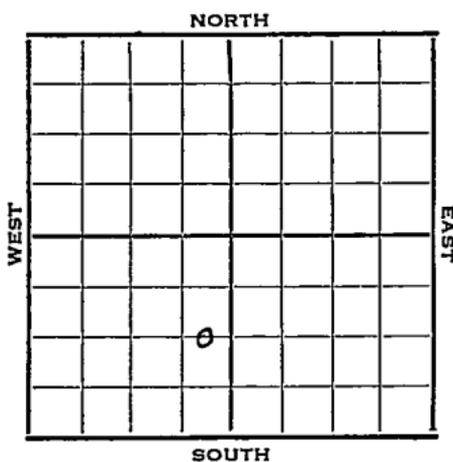

1951 Elev. 1494' REPORT

11/21 Location

1952

1/23

Spud 11-20-51
Oil well TD 3404
8" @ 321
Miss 3294-3370
5" @ 3370 19/ 3327-33 28/ 3337-46
1000 A DD 3381 DD 3404 1500A
5 BO 25 BWPD 1000 A 5 BOPD 20 BW
Comp. 1 $\frac{1}{2}$ BOPD 20 BW

COMPLETED

County Harvey State Kansas

Sec. 5 (Blk. 23) (Sur. 3W) (Twp.) (Rge.) Map No.

Operator Gilcrease Oil

Well No. 5 Farm Vogt

Elev. _____ Location C E L E $\frac{1}{2}$ SW

FIRST REPORT

1320 Ft. From N Line SW

330 Ft. From E Line Quarter

Ist. Report NOV 21 1951

Completion _____

Remarks _____

Carey Drlg. - Contr.

Spudding Date _____

Drlg. Data Burton Pool

Location _____

J. E. TYRA

