


Section 5 Township 23 Range 14 W

Well No. # 1 Holbrook

Company Natural Gas & Oil

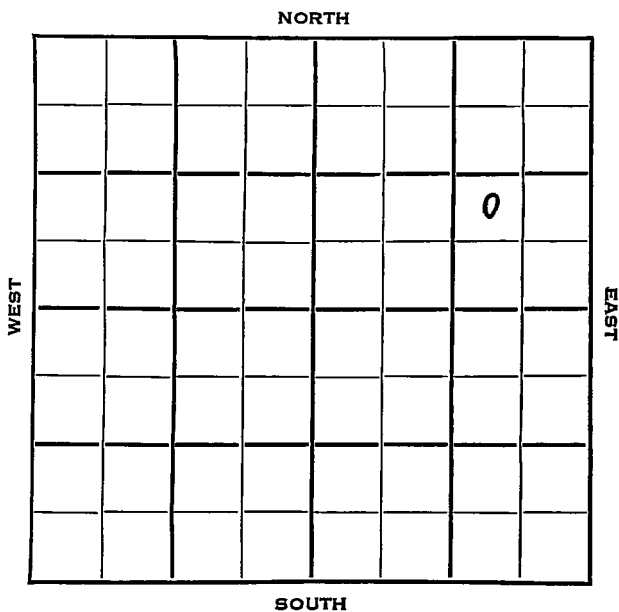

Sec. 5 Twp. 23 R. 14 W

Well No. # 1 Holbrook Farm

Natural Gas & Oil Company

Natural Gas & Oil Contractor

Wildcat


 Ft. from N. Line

990 Ft. from S. Line

990 Ft. from E. Line

 Ft. from W. Line

NW SE NE
Sinclair 50% int.

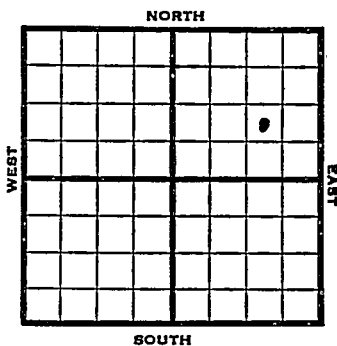

1953

Elev. 1967'

REPORT

6/24

Spud 6-23-53

7/1

10" @ 250
Drlg. 3120

7/8

Heeb 3416 Br li 3548 Lans 3560
DST 3678-3700, 1 hr, 900' gas, 90'
OCM 130#
DST 3712-40, 1 hr, 5' M 54#
Drlg. 3910'

7/15

Spud 6-23-53
D&A
TD 4090
10" @ 250
Heeb 3416, Br lime 3548, Lans 3560
DST 3678-3700, opn 1 hr., rec. 900'
gas, 90' ocm, 130#
DST 3712-40, opn 1 hr., rec. 5' mud,
54#
Viola 3910
DST 3928-58, opn 1 hr., rec. 3' mud,
Simp 3983
DST 3972-4010, opn 1 hr., rec. 150' gas
90' so & gcm,
Arb. 4038
TD 4090
D&A

ABANDONED

