


Pawnee KANSAS

DX 78-1

Section 5 Township 23 Range 17W  
Well No. 1 Clepper (Klepper)  
Company Welch & Olsson

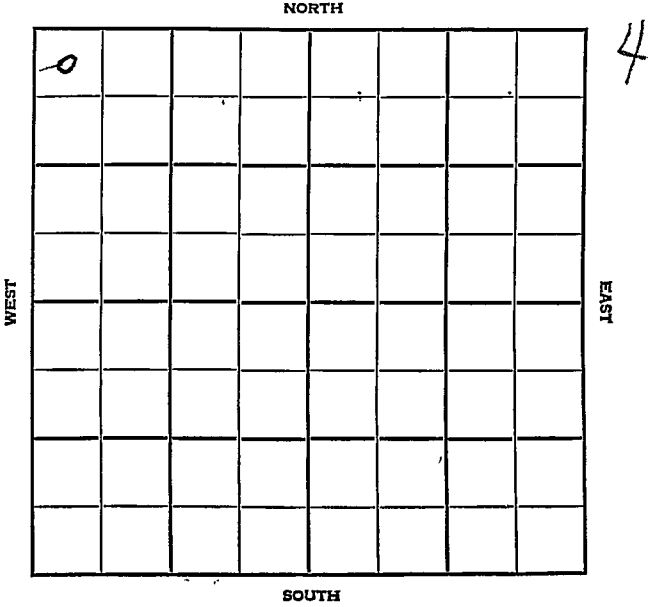

Pawnee KANSAS

SEC.	TWP.	R.
5	23	17W

WELL NO. **1 Clepper** FARM

COMPANY **Welch & Olsson**

CONTRACTOR **Welch & Olsson**


**Wildcat**

330 Ft. from N. Line

\_\_\_\_\_ Ft. from S. Line

330 Ft. from E. Line

\_\_\_\_\_ Ft. from W. Line

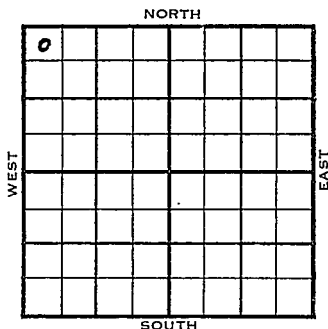

NW NW NW

1954	ELEVATION	REPORT
	2065'	

6/15

C.& P

6/23

8" @ 236

Drlg. 2700'

6/30

Drlg. 4000' tite

7/7

NR

9/1

Spud 6-17-54

Oil Well

TD 4318'

8" @ 236'

Heeb 3619', Lans 3730', Cong 4152'

DST 4150'-86' opn 1 hr, rec 30' Mud Off

DST 4186'-4201' opn 1 hr, rec 40' socm

Off Miss 4186' Misener 4249'

DST 4242'-52' opn 1 hr, rec 40' ocm

60' vhocw, 1860' gas, 840# Viola 4279'

TD 4318'

5" @ 4317'

16/ 4242-46 frac. S/ 2 boph 6 hr.

Comp 85 bopd.

**COMPLETED**



County Pawnee State Kansas

Sec. 5 (Blk. 23) (Sur. 17W) (Twp. Rge.) Map No.

Operator Welch & Olsson Drlg.

Well No. 1 Farm Klepper

Elev. 2065 Location NW NW NW

0					

330Ft. From N Line NW

330Ft. From W Line Quarter

Ist. Report

Completion SEP 1 1954

Remarks Wildcat

Welch & Olsson - Contr.

Spudding Date 6-17-54

Drlg. Data Oil well TD 4318

8" @ 236 Heeb. 3619 Lans. 3730

Cong. 4152 DST 4150-86 open 1 hr.

Rec. 30' mud 0# DST 4186-4201

open 1 hr. Rec. 40' socm 0# Miss. 4186

Misener 4249 DST 4242-52 open 1 hr.

Rec. 40' ocm 60' vhoew 1860' gas

840# Viola 4279 TD 4318 5" @ 4317

16/ 4242-46 frac S/ 2 boph 6 hr.

Comp. 85 bopd

FABEN GILSTRAP