


Section 5 Township 23 Range 17W

Well No. #3 Hutchinson "B"

Company Welch & Olsson

NORTH

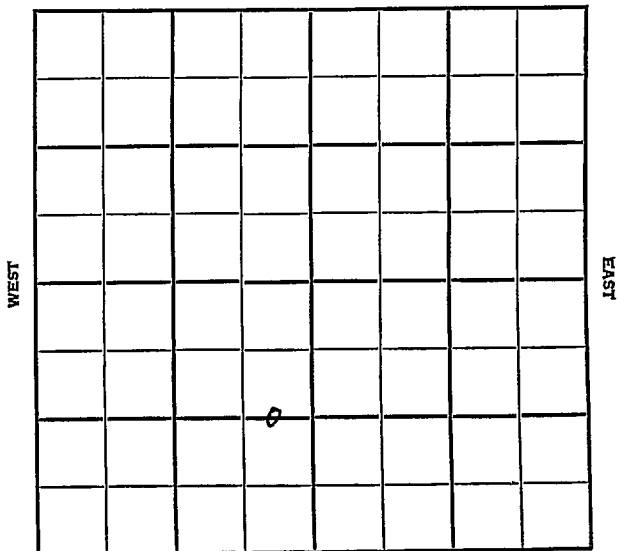

Pawnee

KANSAS

SEC. 5	TWP. 23	R. 17W
-----------	------------	-----------

WELL NO. #3 Hutchinson "B" FARM

COMPANY Welch & Olsson


CONTRACTOR

1320 \_\_\_\_\_ Ft. from N. Line

\_\_\_\_\_ Ft. from S. Line

330 \_\_\_\_\_ Ft. from E. Line

\_\_\_\_\_ Ft. from W. Line

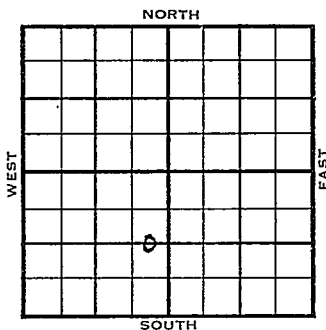

C E $\frac{1}{2}$  E $\frac{1}{2}$  SW

	ELEVATION	REPORT
1954	2061'	

10/13 Spud 10-5-54  
Dr1g. 3744'

11/23 Spud 10-5-54 - Oil Well  
TD 4295'  
Heeb 3602', Br. lime 3708', Lans 3718',  
ong. 4134'  
DST 4130-70', opn 1 hr., gas in 1 hr.,  
rec. 210' ho&gcm, 800#  
Miss 4172'  
DST ~~41~~ 4168-95', opn 1 hr., rec. 60'  
sgcm, 0#  
Misener 4200', Viola 4245'  
TD 4295'  
5" @ 4294'  
CO to 4210'  
30/3199-4204, frac  
F/40 boph  
Comp. 356 bopd

**COMPLETED**

County Pawnee State Kansas

Sec. 5 (Blk. Twp.) 23 (Sur. Rge.) 17W Map No.

Operator Welch & Olsson

Well No. 3 Farm Hutchinson "B"

Elev. 2061 Location C E $\frac{1}{2}$  E $\frac{1}{2}$  SW


1320 Ft. From N Line SW

330 Ft. From E Line Quarter

1st. Report OCT 13 1954

Completion \_\_\_\_\_

Remarks \_\_\_\_\_

Spudding Date 10-5-54

Drlg. Data \_\_\_\_\_

drlg. 3744

FABEN GILSTRAP

