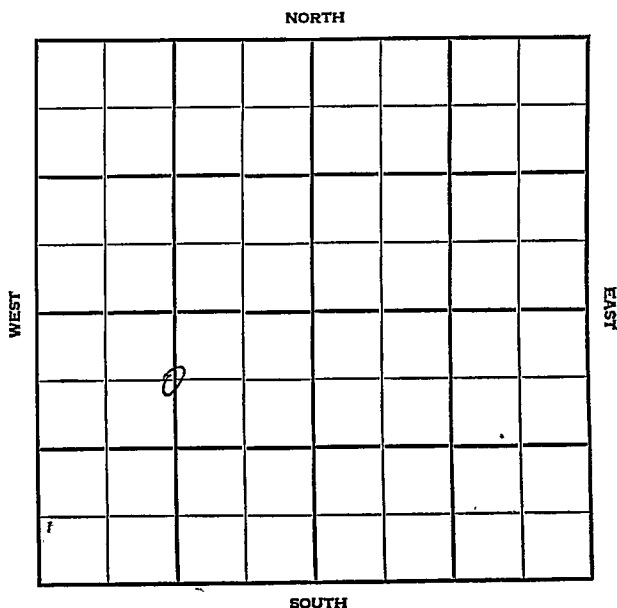


Section 5 Township 23 Range 17WWell No. #4 Hutchinson "B"Company Welch & Olsson & Colorado O&G

Pawnee KANSAS

SEC.	TWP.	R.
5	23	17W

WELL NO.

4 Hutchinson "B"

FARM

COMPANY

Welch & Olsson & Colorado O&G

CONTRACTOR

Welch & Olsson

Garfield Pool


_____ Ft. from N. Line

1320 _____ Ft. from S. Line

_____ Ft. from E. Line

1320 _____ Ft. from W. Line

C SW/4

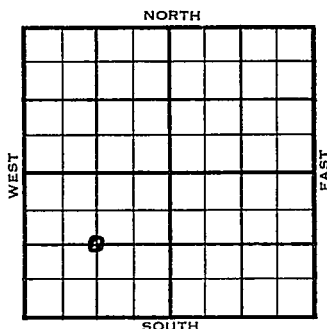

	ELEVATION	REPORT
1955	2064'	

3/23

Spud 3-16-55
8" @ 223'
Drlg. 3295'

County Pawnee State Kansas
 Sec. 5 (Blk.) 23 (Sur.) 17W Map No.
 Operator Welch & Olsson & Colorado O & G
 Well No. 4 Farm Hutchinson "B"
 Elev. 2064 Location C SW/4

FIRST REPORT

1320 Ft. From S Line SW

1320 Ft. From W Line Quarter

1st. Report MAR 23 1955

Completion

Remarks

Welch & Olsson - Contr

Spudding Date 3-16-55

Garfield Pool

Drlg. Data

8" @ 223 drlg. 3295

FABEN GILSTRAP