


DX 78-1 Pawnee

KANSAS

Section 5 Township 23S Range 17W

Well No. #8 Hutchinson Est "B"

Company Welch & Olsson

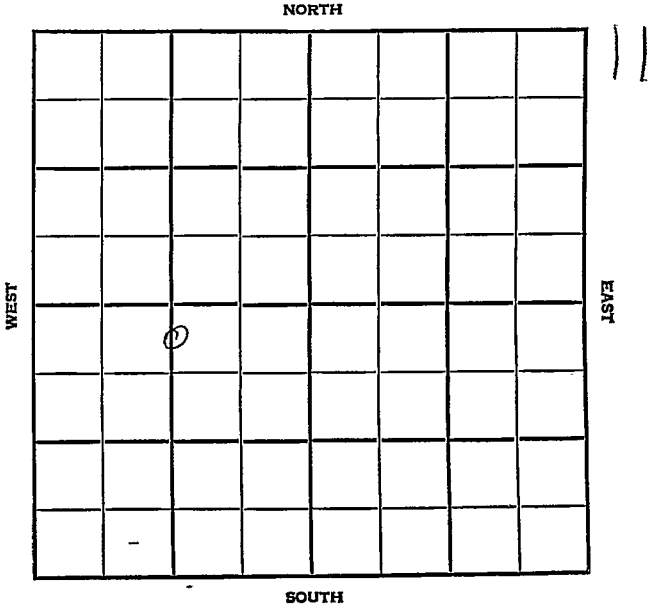

Pawnee

KANSAS


SEC. 5	TWP. 23	R. 17W
-----------	------------	-----------

WELL NO. #8 Hutchinson Est. "B" FARM

COMPANY Welch & Olsson

CONTRACTOR Co. Garfield

_____ FT. FROM N. LINE
 _____ FT. FROM S. LINE
 _____ FT. FROM E. LINE
 _____ FT. FROM W. LINE

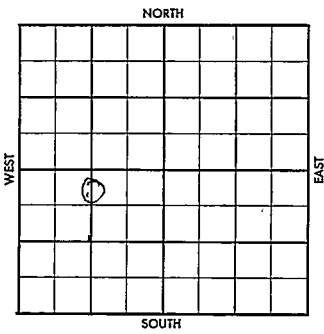

, N $\frac{1}{2}$ N $\frac{1}{2}$ SW

1956	ELEVATION	REPORT
------	-----------	--------

8-29	Comm. 8-24-56 8" @ 196 w/175 Drlg. 2100' Anh. 1107'	
------	--	--

County Parmer Elev. _____
 Sec. 5 Twp. 23S Rge. 17W
 Company Welch & Olsson
 Farm Name Hutchinson Est. "B" No. 8

TOPS	DEPTH	LOG	DATUM
Anh.	1107		
Tr.			
Dg.			
Bl.			
L.			
K.C.			
B.K.C.			
Ce.			
C.			
M.			
M.			
K.			
Mz.			
Me.			
V.			
S.			
S.			
A.			
R.			
Pe.			
G.			
T.D.			

Loc. in Sec. N $\frac{1}{2}$ N $\frac{1}{2}$ SW

Geol. _____
 Contr. _____

Co. #1

Pool Garfield

FIRST REPORT	
0	
AUG 29	'56

Date Comm. 8-21-56
8th 196 w/195. D 2100

8261 2432

Co.
Lse.
No.
Sec.
T.
R.

County Pawnee Elev. 2062^m
 Sec. 5 Top. 23S Rge. 17W
 Company Welch & Olsson
 Farm Name Hutchinson Est. "B" No. 8

TOPS	DEPTH	LOG	DATUM	Loc. in Sec.
Anh.	1107			N $\frac{1}{2}$ N $\frac{1}{2}$ SW
TP.				
H.	3602			
Tr.				
Dg.				
Bl.	3709			
L.	3718			
K.C.				Geol.
R.K.C.				Contr.
Ce.				
C. <u>5h</u>	4139			Co. #1
M. <u>co chest</u>	4172			
M.				Paol.
K.				Garfield
Mz.				
Mo.				
V.				
S.				
S.				
A.				
R.				
PE.				
G.				
TD.	4300			

COMPLETE

OCT 24 '56

Date Comm. 8-21-56

8" 196 w/1.75; D 2100 SEP 5 '56

DST 4138-75 lhr 1920' gae

+ 25' S.GCM BHP 320/60"

DST 4175-4200 lhr 2800' 61R

rec. 140' HO S.GCM BHP 1300/lhr

DST 4205-30 lhr rec 50' Md

FP 0-0 BHP 460/60" DST SEP 12 '56

4230-60 lhr rec 115' Md BHP

690/30" 5 1/2 ~~48~~ 4257 1/2 lhr w/oct

SEP 19 '56

SEP 26 '56 CO 4271 28/4217-4222

tst 3 Gwph + sc. oil 3 hrs

1/4" \$ app: 1 Boph 20% wtr

3 1/2 hrs Frac 4 x 4 Lost Load

PB 4208 29/4176-4181 ~~4181~~

FU 50' oil no/wtr in 15" \$ app

1 Boph no/w 10 hrs + Gas. no

gauge Ran T69 Frac 5 x 4 1/4"

\$ Ld. OCT 7 '56 \$ 4 Boph no/w

10 hrs OCT 10 '56 10Y OCT 17 '56 X No pot

OCT 24 '56 Ph. P. 145-Boyd

no/wtr.