


Section 5 Township 23 Range 17 W

Well No. #2 State River

Company Welch & Olsson

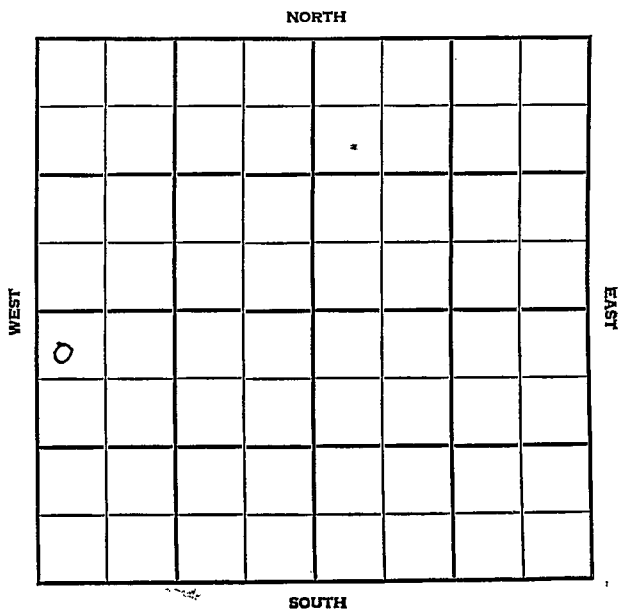

12

1

Pawnee

SEC.	TWP.	R.
5	23	17W

WELL NO. #2 State River

FARM

COMPANY

Welch & Olsson

CONTRACTOR

Co. Tools

Garfield


_____ Ft. from N. Line

_____ Ft. from S. Line

_____ Ft. from E. Line

_____ Ft. from W. Line

NW NW SW

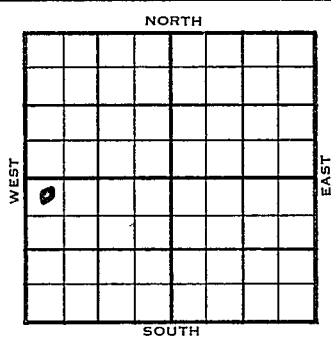

L955	ELEVATION	REPORT
	2063'	

8/3 Comm. 7-30-55
8" @207/175 ^Urlg. 1425 **FIRST REPORT**

9-21 5 1/2" @ 4304
DST 4160-4225 op 1 hr. rec. 60' mud,
BHP 125# 30"
DST 4226-55 op 90" rec. 60' so&gcm
180' oil & gcm, 120' ho & gcm, BHP
850# 45";
DST 4260-4303 op 1 hr. rec. 160' mud,
BHP 985# 45";
CO 4260; 30/4239-43; no test; frac;
pmp 4 boph no wtr.
Phy. pmp 76 bopd no wtr.
Tops: H. 3626
B.L. 3732
L. 3741
Shly 4165
Mz. 4225
V. 4293
T.D. 4305'

COMPLETED

County Pawnee Elev. _____
 Sec. 5 Twp. 23 Rge. 17W
 Company Welch & Olsson
 Farm Name State River No. 2

TOPS	DEPTH	LOG	DATUM
Anh.			
Tr.			
Dg.			
Bl.			
L.			
K.C.			
B.K.C.			
Ce.			
C.			
M.			
M.			
K.			
Mz.			
Ma.			
V.			
S.			
S.			
A.			
R.			
P.C.			
G.			
T.D.			

Loc. in Sec. NW NW SW

Geol. _____

Contr. _____

Co. tools

Pool

Garfield

FIRST REPORT

AUG 3 '55

Date Comm. 7-30-55
8" @ 207/175 drlg. 1425

[Handwritten signature]

Co.

Lse.

No.

Sec.

T.

R.

County Pawnee Elevation 2063
 Sec. 5 Twp. 23S Rge. 17W
 Company Welch & Olsson
 Farm Name State River No. 2

TOPS	DEPTH	LOG	DATUM	Loc. in Sec.
Anh.				NW NW SW
TP.				
H.	3626		1563	
Tr.				
Dg.				
BL.	3732		1669	
L.	3741		1678	
K.C.				Geol.
B.K.C.				Contr.
Ce.				
C. <u>Shly</u>	4165		2102	Co. tools
M.				
M.				
K.				
Mz.	4225		2162	Garfield
Me.				
V.	4293		2230	
S.				
S.				
A.				COMPLETE
R.				
PE.				
G.				
T.D.	4305			

Date Comm. 7-30-55 SEP 21 1955

8" 207 w/175; 5 1/2" 4304; DST 4160-4225
 op 1 hr., rec. 60' mud, BHP 125# 30";
 DST 4226-55 op 90" rec. 60' so and gcm
 180' oil and gcm, 120' ho and gcm, BHP
 850# 45"; DST 4260-4303 op 1 hr. rec. 160'
 mud, BHP 985# 45"; CO 4260; 30/4239-43;
 no test; frac; pmp 4 boph no wtr.;
 Phy. pmp 76 bopd no wtr.