


Pawnee KANSAS

DX 78-1

Section 5 Township 23 Range 17W
 Well No. 1 A. W. Schartz
 Company Hilton Drlg.

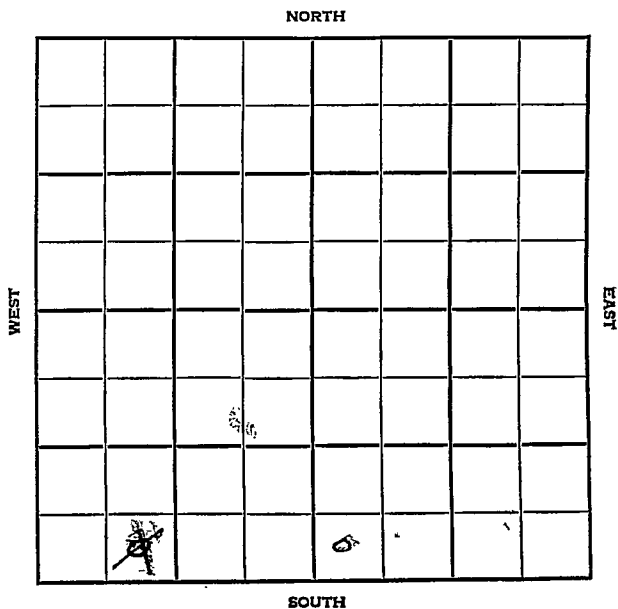

15

Pawnee KANSAS

SEC.	TWP.	R.
5	23	17W

WELL NO.

1 A. W. Schartz

FARM

COMPANY

Hilton Drlg.

CONTRACTOR

Hilton Drlg.

Garfield Pool

Ft. from N. Line

330

Ft. from S. Line

990

Ft. from E. Line


330

990

Ft. from W. Line

~~SW SW SE~~

~~SE SW SW~~

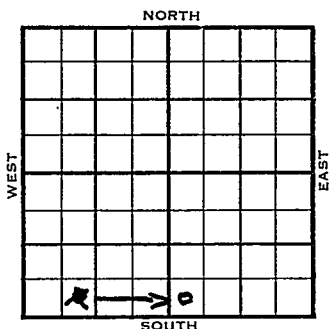

1954

ELEVATION

2067'

REPORT

6/30

Spudding 6-25-54

8" @ 170

Drlg. 1805

7/7

Drlg. 4035'

8/4

Spud 6-25-54 Oil well TD 4300

8" @ 170 Heelg 3611' Br. lime 3716

Lans. 3723 Miss. 4182 Misener 4209

Viola 4263 TD 4300 5" @ 4299

CO F/oil on DST CO to 4275

36/4210-16 frac. F/88 BOPH

Comp. 3000 BOPD

COMPLETED

County Pawnee State KansasSec. 5 (Blk.) 23 (Sur.) 17W Map No.Operator Hilton Drlg.Well No. 1 Farm A. W. SchartzElev. Location SE SW SW

FIRST REPORT

330 Ft. From S Line SW990 Ft. From W Line Quarter1st. Report JUN 30 1954

Completion

Remarks

Hilton Drlg. - Contr.Spudding Date 6-25-54Drlg. Data Garfield Pool8" @ 170 drlg. 1805

J. G. McGEHEE

Kansas

Map No. _____ Sec. 5 Twp. 23 R. 17WWell No. 1 A. W. Schartz

Hilton Drlg. _____ Company

CORRECTION

Contractor _____

SW SW SE

SECTION PLAT

		o	

_____ Ft. from N. Line

330 Ft. from S. Line

_____ Ft. from E. Line

330 Ft. from W. Line

Pawnee County

Location _____

Rig up _____

Drilling and Remarks:

Reported
SE SW SW

RECORD

Cased _____ in., _____ ft.

Sand _____

Gas _____

Oil _____

Total Depth _____

PRODUCTION

1st 24 hrs. Nat. _____

1st 24 hrs. after shot _____

Gas _____ Cu. Ft.

Dry Hole _____

Abandoned _____

Date,

JUL 7 1954 19

J. G. McGEHEE

Scout

J. G. McGEHEE