


Section 5 Township 23 Range 34W

Well No. #1 Meyer "C"

Company Cities Service O.1

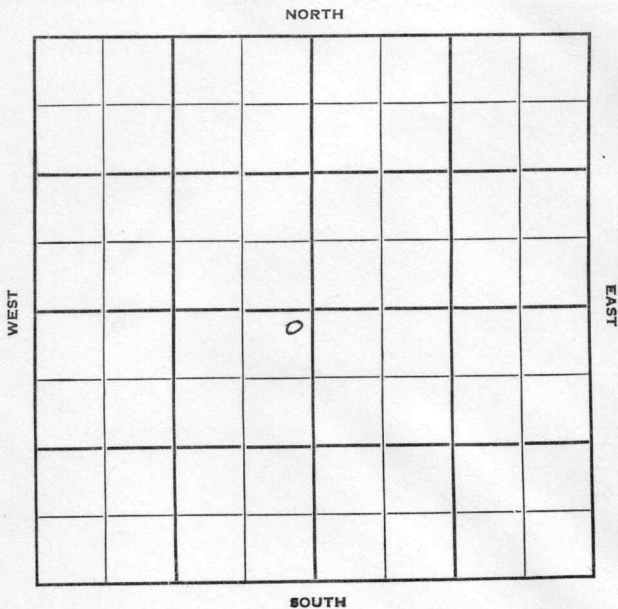

Finney

KANSAS

Sec. 5 Twp. 23 R. 34W

Well No. #1 Meyer "C" Farm

Cities Service Oil Company

Contractor

Hugoton Pool


100' Ft. from N. Line

Ft. from S. Line

100' Ft. from E. Line

Ft. from W. Line

NE SW

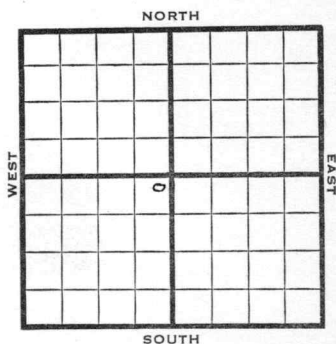

1950

Elev.

REPORT

4/26

Location

6/7

8" @ 520'

5" @ 2664'

Krider 2495'

Win 2538'

Up Ft 2608

Opn flow 7,450,000

TD 2647'

COMPLETED

Map No. _____ Sec. 5 Twp. 23 R. 34WWell No. 1 Meyer "C"

_____ Cities Service Oil _____ Company

_____ Contractor

NE SW

SECTION PLAT

100 Ft. from N. Line

_____ Ft. from S. Line

100 Ft. from E. Line

_____ Ft. from W. Line



Finney County

Location X

Rig up _____

Drilling and Remarks: _____

RECORD

Cased _____ in., _____ ft.

Sand _____

Gas _____

Oil _____

Total Depth _____

PRODUCTION

1st 24 hrs. Nat. _____

1st 24 hrs. after shot _____

Gas _____ Cu. Ft.

Dry Hole _____

Abandoned _____

Date

APR 26 1950 19 J. E. TYRA Scout

Kansas

Map No. _____ Sec. 5 Twp. 23 R. 34WWell No. 1 Meyer "C"

_____ Cities Service _____ Company

_____ Contractor

NE SW

SECTION PLAT

100 Ft. from N. Line

_____ Ft. from S. Line

100 Ft. from E. Line

_____ Ft. from W. Line

Finney

Location _____

Rig up _____

Drilling and Remarks:

8" @ 520
 5' 2664
 Kridler 2495
 Win 2538
 up Ft. 2608
 open flow

RECORD

Cased _____ in., _____ ft.

Sand _____

Gas _____

Oil _____

Total Depth 2647

PRODUCTION

1st 24 hrs. Nat. _____

1st 24 hrs. after shot _____

Gas _____ Cu. Ft.

Dry Hole _____

Abandoned _____

Date

7,450,000JUN 7 1950 19J. E. TYRA Scout