


Kearny

KANSAS

Section 5 Township 23 Range 35W

Well No. #1 Gray

Company Stanolind Oil and Gas Company

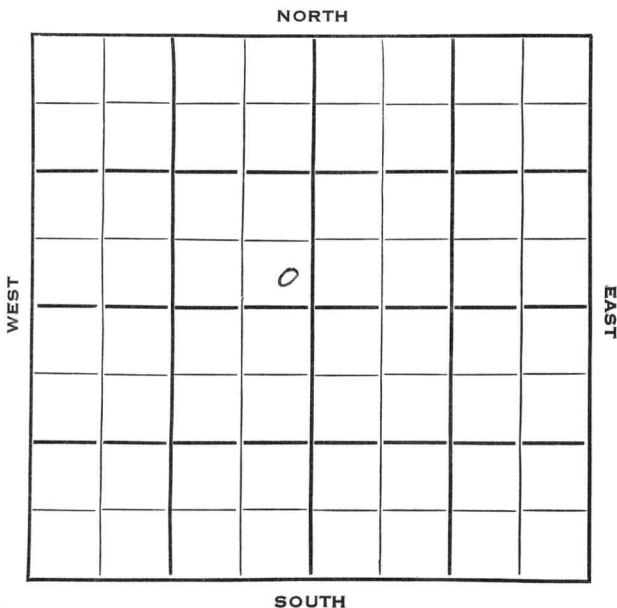

Sec. 5 Twp. 23 R. 35 WWell No. # 1 Gray FarmStanolind Company


Contractor

Ft. from N. Line

150 Ft. from S. Line150 Ft. from E. Line

Ft. from W. Line

SE NW

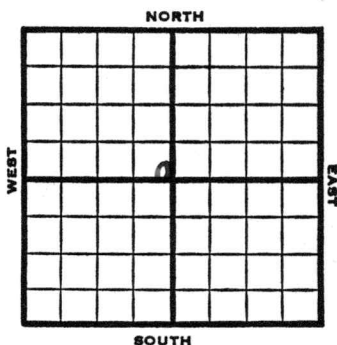

1953 Elev. 3098' REPORT

3/25 Location

4/2 MI

4/9 8" @ 849

Drlg. 2660'

4/16 Her 2571, Win 2626,

TD 2660'

5" @ 2626'

CO 2650

3000 - A-frac 1500 A

4/23 PB 2616 72/ 2571-83 30/ 2590-95
30/ 2597-2602 42/ 2606-13 4500 A

4/29 Spud 3-30-53 Gas well TD 2660'

8" @ 849 Her. 2571 Win 2626

TD 2660 5" @ 2626 CO to 2650

3000 A-frac. 1500 A PB 2616

72/2571-83 30/2590-95 30/2597-

2602 42/2606-13 4500 A

Comp. 12,206,000 gas

COMPLETED

County Kearny State Kansas

Sec. **5** (Blk.) **23** (Sur.) **35W** Map No.

Operator **Stanolind**

Well No. **1** Farm **Gray**

Elev.	Location	SE	NW

0

FIRST REPORT

150 Ft. From S Line NW

150 Ft. From. E Line Quarter

1st. Report MAR 25 1953

Completion _____

Remarks


Spudding Date _____

Drlg. Data

Location

J. G. McGEHEE

County Kearny State Kansas
 Sec. 5 (Blk. 23 (Sur. 35W Map No.
 (Twp.) (Rge.)
 Operator Stanolind
 Well No. 1 Farm Gray
 Elev. 3098 Location SE NW

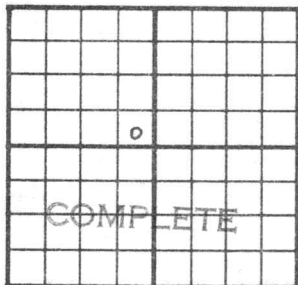

150 Ft. From S Line NW
150 Ft. From E Line Quarter

1st. Report

Completion APR 29 1953

Remarks

Spudding Date 3-30-53

Drlg. Data Gas well TD 2660

8" @ 849 Her. 2571 Win. 2626

TD 2660 5" @ 2626 CO to 2650 3000 A-fra

1500 A PB 2616 72/ 2571-83 30/ 2590-95

30/ 2597-2602 42/ 2606-13 4500 A

Comp. 12,206,000 gas