


Section 5 Township 23 Range 37W

Well No. #1 Weber "A"

Company Graham Michaelis

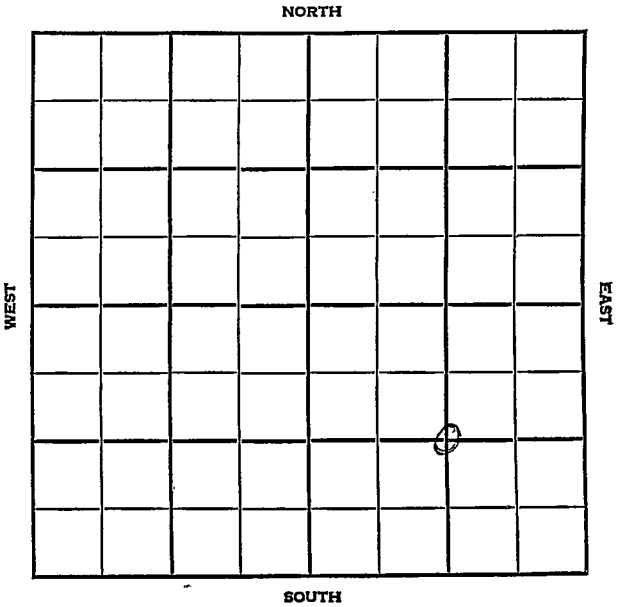

County Kearny Elev. _____
 Sec. 5 Twp. 23 Rge. 37W
 Company Graham Michaelis
 Farm Name Weber "A" No. 1

| TOPS | DEPTH | LOG | DATUM |
|--------|-------|-----|-------|
| Anh. | | | |
| Tr. | | | |
| H. | | | |
| Tr. | | | |
| Dg. | | | |
| Bl. | | | |
| L. | | | |
| K.C. | | | |
| B.K.C. | | | |
| Ce. | | | |
| C. | | | |
| M. | | | |
| M. | | | |
| K. | | | |
| Mz. | | | |
| Me. | | | |
| V. | | | |
| S. | | | |
| S. | | | |
| A. | | | |
| R. | | | |
| PE. | | | |
| G. | | | |
| T.D. | | | |

Loc. in Sec. _____
C SE/4
 Geol. _____
 Contr. _____
 Co. Tools _____
 Pool _____
Hugoton

FIRST REPORT

| | |
|--|--|
| | |
| | |
| | |

OCT 31 '58

Date Comm. _____
 Location Est. TD 2625'

37

R. G.

Co.
Lse.
No.
Sec.
T.
R.

County Kearny Elev. 3309 DF
 Sec. 5 Twp. 23 Rge. 37W
 Company Graham Michaelis
 FarmName Weber "A" No. 1

| TOPS | DEPTH | LOG | DATUM | Loc. in Sec. |
|--------------------|-------------|-----|-------|--|
| Anh. | | | | C SE/4 |
| Tp. <u>Herr Kn</u> | <u>2568</u> | | | |
| H. | | | | |
| Tr. | | | | |
| Dg. | | | | |
| BL. | | | | |
| L. | | | | Geol. |
| K.C. | | | | Contr. |
| B.K.C. | | | | Co. Tools |
| Ce. | | | | Pool |
| C. | | | | Hugoton |
| M. | | | | <div style="border: 1px solid black; padding: 5px; text-align: center;"> <p>COMPLETE</p> <p>NOV 23 '56 0</p> </div> |
| M. | | | | |
| K. | | | | |
| Mz. | | | | |
| Mo. | | | | |
| V. | | | | |
| S. | | | | |
| S. | | | | |
| A. | | | | |
| R. | | | | |
| PE. | | | | |
| G. | | | | |
| TD | <u>2581</u> | | | |

Date Comm. NOV 7 '56 10-30
 Location Est. TD 2625' NOV 7 '56 10-30
-56 8 5/8 307/1275 5 1/2 2568/300
DD 2596 NOV 13 '56 12 N.S. DD
2624 ga 300 MCF Frac P x 8
ga 4 Mill . NOV 21 '56 72-20
13,435 MCF 6 RP 412#

Co. No. Sec. T. R.