


Harvey

KANSAS

Section 6 Township 23 Range 3W

Well No. #6 Frederick

Company Drillers Prod.

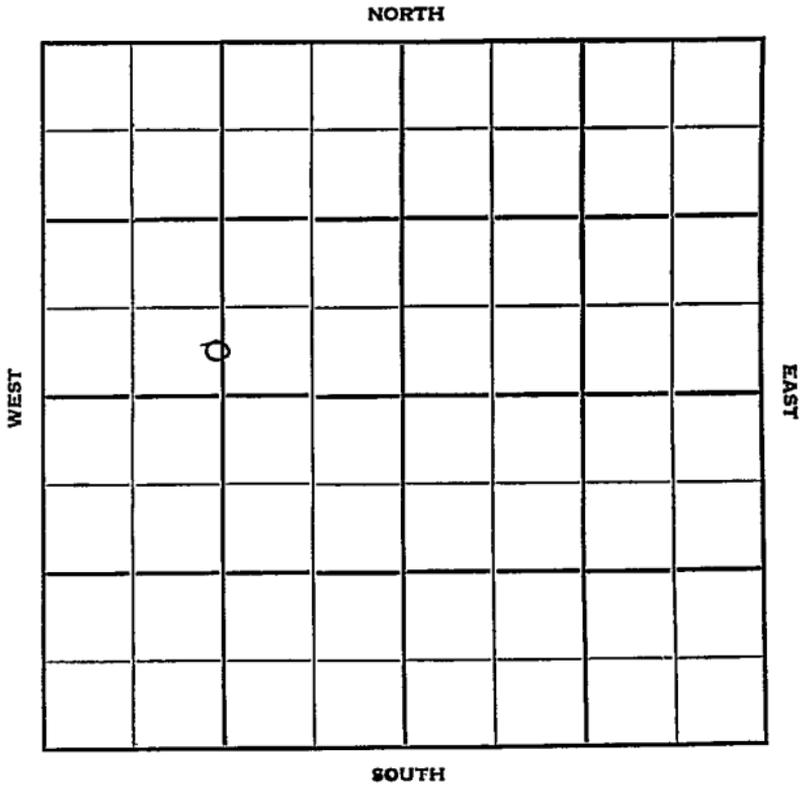

Sec. 6 Twp. 23 R. 3W

Well No. #6 Frederick Farm

Drillers Prod. Company

Springer & Harper Contractor

Burton Pool


Ft. from N. Line

462' Ft. from S. Line

Ft. from E. Line

1254' Ft. from W. Line

G S L S  $\frac{1}{2}$  NW

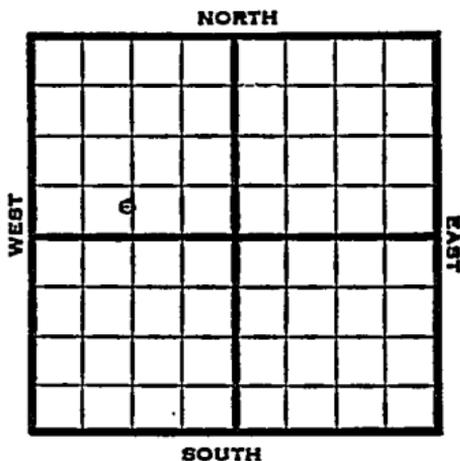

1951

Elev. 1483' REPORT

3/7

RUR

4/11

Spd 3-7-51  
Oil Well TD 3374  
8" @ 315  
Miss 3282  
DST 3304-51 opn 45 min  
Rec. 1 mcfg 90' gcm  
TD 3352 5" @ 3344  
FU 125' oil 16 hr.  
DD 3374 SP 3370 2000 A  
S/2 bo tr w 21/3305-18  
3000 A Comp. F/28 bo 1mcfg

**COMPLETED**

County **Harvey** State **Kansas**

Sec. **6** (Blk.) **23** (Sur. Rge.) **3W** Map No.

Operator **Drillers Prod.**

Well No. **6** Farm **Frederick**

Elev. Location **C SE S $\frac{1}{2}$  NW**

|  |  |  |  |  |  |
|--|--|--|--|--|--|
|  |  |  |  |  |  |
|  |  |  |  |  |  |
**462** Ft. From **S** Line **NW**

**1254** Ft. From **W** Line **Quarter**

1st. Report **MAR 7 1951**

Completion

Remarks

**Springer & Harper - Contr.**

Spudding Date

Drlg. Data **Burton Pool**

**R U R**

County Harvey State Kansas

Sec. 6 (Blk. 23 (Sur. 3W (Twp. Rge.) Map No.

Operator Drillers Prod.

Well No. 6 Farm Frederick

Elev. 1483 Location C S L S $\frac{1}{2}$  NW

|  |  |  |  |  |  |
|--|--|--|--|--|--|
|  |  |  |  |  |  |
|  |  |  |  |  |  |
462 Ft. From S Line NW

1254 Ft. From W Line Quarter

1st. Report

Completion APR 11 1951

Remarks Burton Pool

Springer & Harper - Contr

Spudding Date 3-7-51

Drig. Data Oil well TD 3374

8" @ 315 Miss. 3282 DST 3304-51

open 45 min. Rec. 1 mcfg 90' gcm

TD 3352 5" @ 3344 FU 125' oil 16 hr.

DD 3374 SP 3370 2000 A S/ 2 bo tr w

21/ 3305-18 3000 A Comp. F/ 28 bo lmcfg

J. E. TYRA