


Section 6 Township 23 Range 3 W

Well No. # 12 Fredrick

Company Drillers Prod.

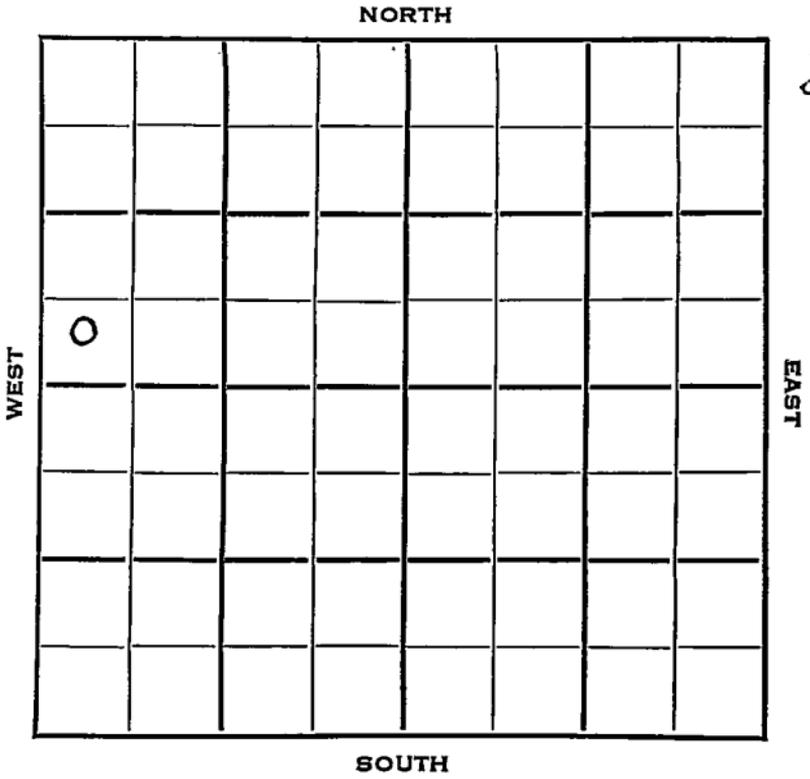

Harvey

KANSAS

SEC. 6	TWP. 23	R. 3 W	✓
-----------	------------	-----------	---

WELL NO. # 12 Fredrick FARM

COMPANY

CONTRACTOR Drillers Prod.

Springer & Harper


_____ Ft. from N. Line

462 _____ Ft. from S. Line

_____ Ft. from E. Line

330 _____ Ft. from W. Line

SW SW NW

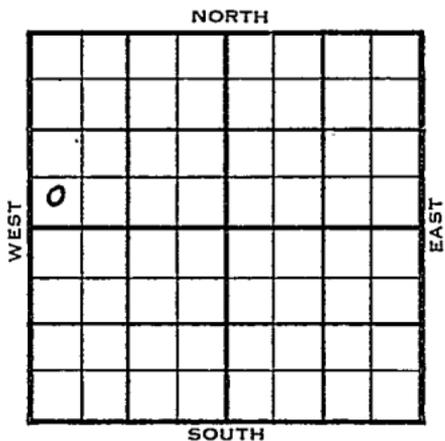

1953	ELEVATION 1472'	REPORT
------	--------------------	--------

12/16 MIR

1954
1/20

Spud 12-16-53
Oil Well
TD 3394'
8" @ 326'
Miss 3277'
TD 3340'
5" @ 3338'
DD 3381', 1000A
S/15 go 75 gwph
DD 3394'
Comp. 7 bopd 40 bw

COMPLETED

County Harvey State Kansas

Sec. 6 (Blk.) 23 (Sur.) 3W Map No.

Operator Drillers Prod.

Well No. 12 Farm Fredrick

Elev. 1472 Location SW SW NW

	COMPLETE				

462Ft. From S Line NW

330Ft. From W Line Quarter

1st. Report

Completion JAN 20 1954

Remarks

Springer & Harper - Contr.

Spudding Date 12-16-53

Drig. Data Oil well TD 3394

8" @ 326 Miss. 3277 TD 3340

5" @ 3338 DD 3381 1000 A S/ 15 go

75 gwph DD 3394 Comp. 7 bopd 40 bw