


Section 6 Township 23 Range 3 W

Well No. # 7 Fredrick

Company Drillers Prod.

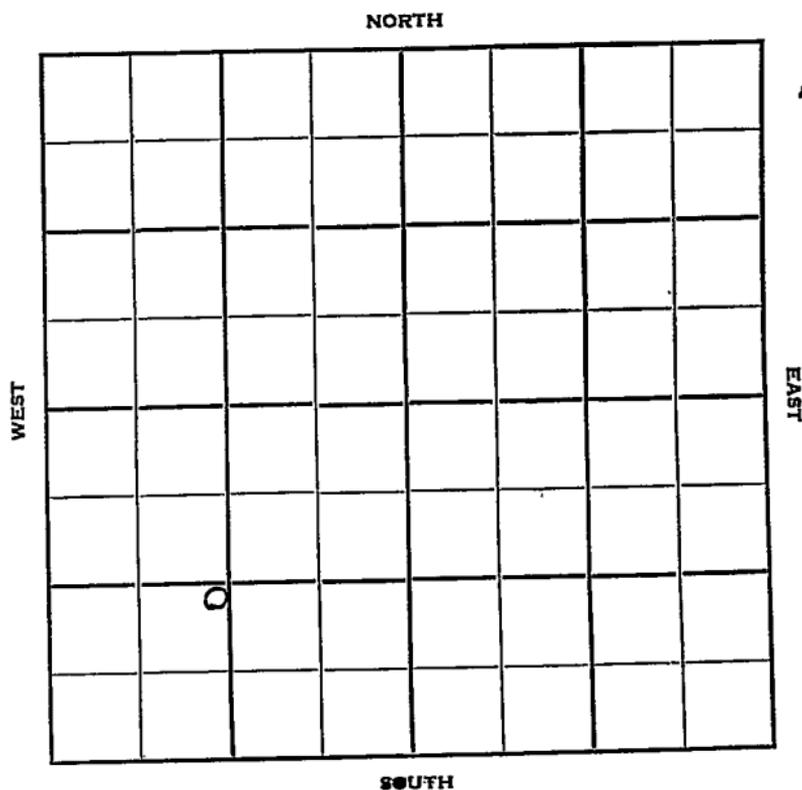

Harvey

KANSAS

Sec. 6 Twp. 23 R. 3 W ✓

Well No. # 7 Fredrick Farm

Drillers Prod. Company

Contractor

**Burrton Pool**


\_\_\_\_\_ Ft. from N. Line

1250 Ft. from S. Line

1386 Ft. from E. Line

\_\_\_\_\_ Ft. from W. Line

NE SW SW

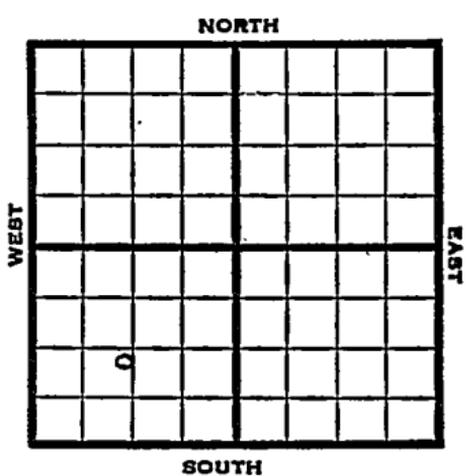

1951 Elev. 1490' REPORT

5/16 R U R  
 7/3 Spud 5-19-51  
 Oil Well TD 3855  
 8" @ 820  
 Lans. 2860 Miss 3287  
 Kh 3628 Hunton 3699  
 Maq. 3782  
 Viola 3817 Simp 3843<sup>±</sup>  
 TD 3855 5½" @ 3471 24/3367-75 wtr  
 24/3367-75 3000 A 3½ bo 2 bwph  
 Comp. 50 bopd 50 bwpd

**COMPLETED**



~~Kansas~~

Map No. \_\_\_\_\_ Sec. 6 Twp. 23 R. 3W

Well No. 7 Fredrick

Drillers Prod. Company

**CORRECTION** Contractor

NE SW SW

SECTION PLAT

\_\_\_\_\_ Ft. from N. Line

1250 Ft. from S. Line

1386 Ft. from E. Line

\_\_\_\_\_ Ft. from W. Line

|   |  |  |  |
|---|--|--|--|
|   |  |  |  |
|   |  |  |  |
|   |  |  |  |
| a |  |  |  |

Harvey County

Location \_\_\_\_\_

Rig up \_\_\_\_\_

Drilling and Remarks: \_\_\_\_\_

Reported

NE NE SW

RECORD

Cased \_\_\_\_\_ in., \_\_\_\_\_ ft.

Sand \_\_\_\_\_

Gas \_\_\_\_\_

Oil \_\_\_\_\_

Total Depth \_\_\_\_\_

PRODUCTION

1st 24 hrs. Nat. \_\_\_\_\_

1st 24 hrs. after shot \_\_\_\_\_

Gas \_\_\_\_\_ Cu. Ft.

Dry Hole \_\_\_\_\_

Abandoned \_\_\_\_\_

Date

JUL 3 1951 19

J. E. TYRA Scout

