


Section 6 Township 23 Range 3W

Well No. 8 Fredrick

Company Drillers Prd.

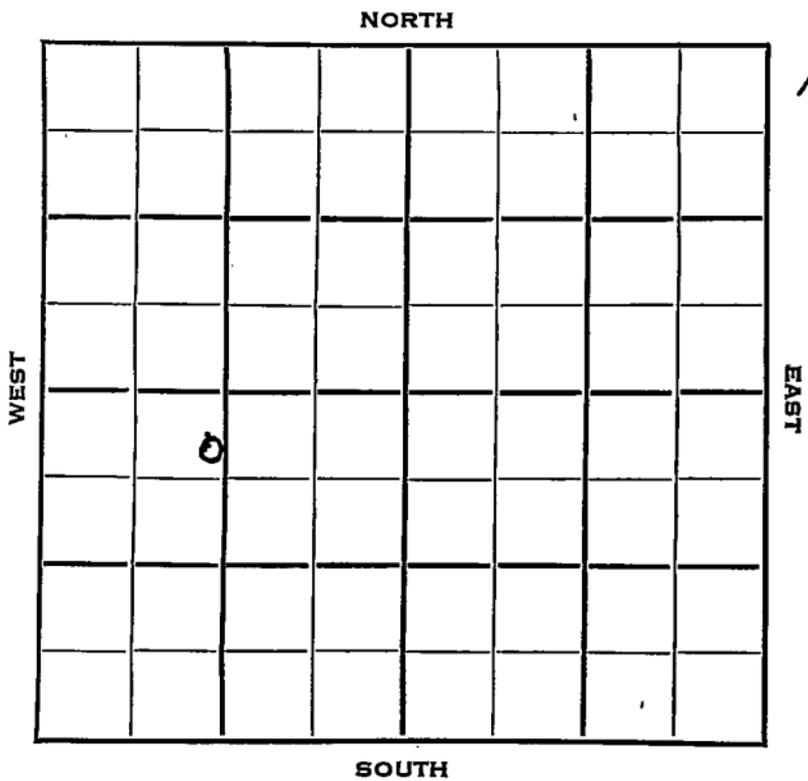

SEC.	TWP.	R.
6	23	3W ✓

WELL NO. **8 Fredrick** FARM

COMPANY

Drillers Prod.

CONTRACTOR **Springer & Harper**


Halstead Pool

436 Ft. from N. Line

_____ Ft. from S. Line

_____ Ft. from E. Line

1254 Ft. from W. Line

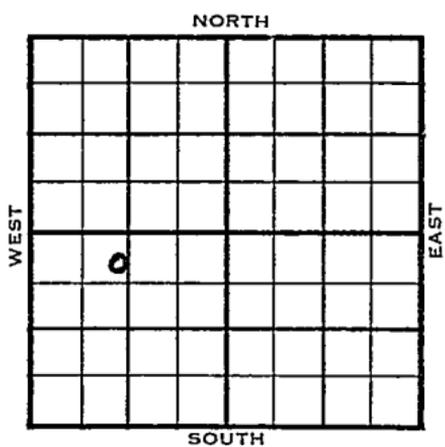

NE NW SW

1953	ELEVATION 1493'	REPORT
------	---------------------------	--------

9/16 Location

9/30 8" @ 302 Anhy 460'
Drlg. 2516'

10/7 Miss 3299
DST 3308'-54' 1 hr, 50' gcm 772#
RTD 3365
5" @ 3360'

10/14 DD 3384
TD
1500 A S/ 22 BO 8 Hrs.

10/21 Spud 9-22-53
Oil Well
TD 3384'
8" @ 302'
Anhy 460', Miss 3299
DST 3308'-54' opn 1 hr, rec 50' gcm
772#
TD 3365'
5" @ 3360'
DD 3384 3000 A S/ 32-bo 8 hr.
45 bsw.
Comp. 77 bopd 50% wtr.

COMPLETED

