


Section 6 Township 23 Range 3W

Well No. 13 Fredrick

Company Drillers Prod.

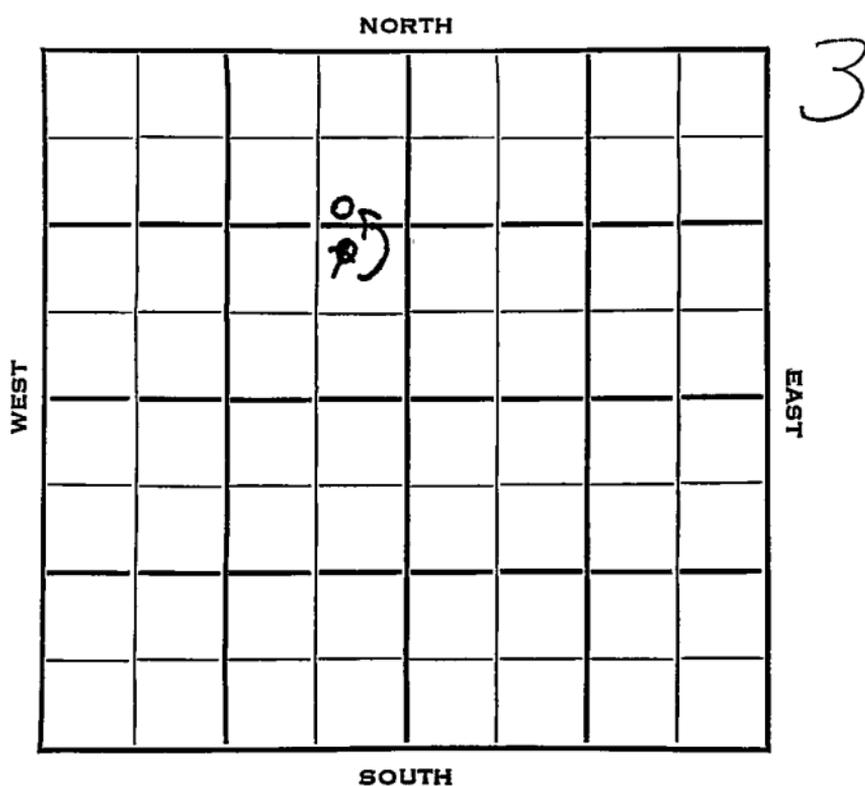

Harvey

KANSAS

SEC.	TWP.	R.
6	23	3W ✓

WELL NO.

#13 Fredrick

FARM


COMPANY

Drillers Prod.

CONTRACTOR

Springer & Harper  
Burton Pool1250 Ft. from N. Line~~1254~~ Ft. from S. Line460  
~~462~~ Ft. from E. Line

Ft. from W. Line

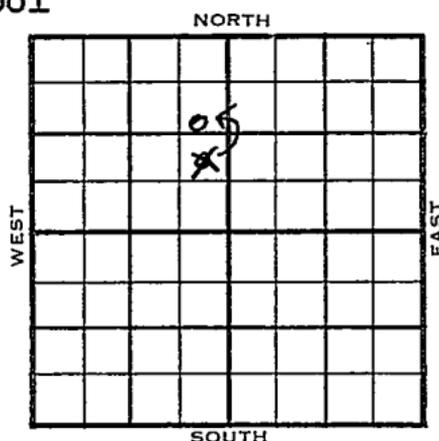~~SE NE NW~~  
~~NE SE NW~~

1954	ELEVATION 1463'	REPORT
------	--------------------	--------

3/10 Spud 3-9-54

3/17 Drlg 2500'  
8" @ 300'3/24 Miss 3257',  
RTD 3337'  
5" @ 3333'4/21 Spud 3-9-54  
Oil Well  
TD 3345'  
8" @ 300'Br. Lime 2505', Lans 2536', Miss 3257'  
TD 3337'  
5" @ 3333'

CO to 3337'

SSG DD 3345' 1000 A  $\frac{1}{2}$  bo  $1\frac{1}{2}$ 

bwph 16 hr. 1000 A

Comp 25 bopd 13 bw.

**COMPLETED**



Map No. \_\_\_\_\_ Sec. 6 Twp. 23 R. 3W

Well No. 13 Fredrick

Drillers Prod. \_\_\_\_\_ Company

**CORRECTION**

Contractor \_\_\_\_\_

SE NE NW

SECTION PLAT

1250 Ft. from N. Line

\_\_\_\_\_ Ft. from S. Line

460 Ft. from E. Line

\_\_\_\_\_ Ft. from W. Line

	o		

Harvey County

Location \_\_\_\_\_

Rig up \_\_\_\_\_

Drilling and Remarks:

Reported  
NE SE NW

RECORD

Cased \_\_\_\_\_ in., \_\_\_\_\_ ft.

Sand \_\_\_\_\_

Gas \_\_\_\_\_

Oil \_\_\_\_\_

Total Depth \_\_\_\_\_

PRODUCTION

1st 24 hrs. Nat. \_\_\_\_\_

1st 24 hrs. after shot \_\_\_\_\_

Gas \_\_\_\_\_ Cu. Ft.

Dry Hole \_\_\_\_\_

Abandoned \_\_\_\_\_

Date

MAR 10 1954

19

I. G. MCELVEE

Scout

