

Section 6 Township 23 Range 9W

Well No. 2 Voldois

Company Cities Service

Peace Creek

NORTH

		o					

WEST

EAST

SOUTH



Sec. 6 Twp. 23 R. 9W

Well No. #2 -Valdois Farm

Cities Service Company


330 Ft. from Peace Creek N. Line

_____ Ft. from S. Line

_____ Ft. from E. Line

990 Ft. from W. Line

NW NE NW

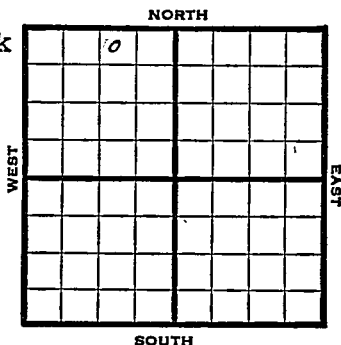

1947

Elev. 1738' R E P O R T

10/22

RUR

10/29

8" @ 253'
Drlg. 3370'

11/5

Lansing 3237'
Mississippi 3569'
Misener 3708'
Viola 3711'
TD 3714
5" @ 3708'
RUST

11/12

SLM 3714-3707'
Viola 3704'
5" @ 3704'
TD 3715' SO

11/19

TD 3737'
500 Acid
Pump 96 bbls oil & 2 W in 24 hrs.

11/25

"

12/3

"

12/10

"

12/23

Viola 3704'
5" @ 3704'
500 acid
Pump 80 Pot
40.0 Gr.
TD 3737'

COMPLETED

Map No. _____ Sec. 6 Twp. 23 R. 9W

Well No. 2 Valdois

Cities Service Company

FIRST REPORT

Contractor

NW NE NW

SECTION PLAT

330 Ft. from N. Line

	o		

Ft. from S. Line

Ft. from E. Line

990 Ft. from W. Line

Reno County

Location _____

RECORD

Rig up _____

Cased _____ in. _____ ft.

Drilling and Remarks:

Sand _____

Gas _____

Oil _____

RUR

Total Depth _____

PRODUCTION

1st 24 hrs. Nat. _____

1st 24 hrs. after shot _____

Gas _____ Cu. Ft.

Dry Hole _____

Abandoned _____

Date

OCT 22 1947 19

S. J. LEWIS Scout

Map No. 41 Sec. 6 Twp. 23 R. 9W

Well No. 2 Valdois

Cities Service Company

COMPLETE

Contractor

NW NE NW

E 11/28
SECTION PLAT

330 Ft. from N. Line

_____ Ft. from S. Line

_____ Ft. from E. Line

990 Ft. from W. Line

	o		

Reno County

Location _____

Rig up _____

Drilling and Remarks:

Vid low 3704

5" C 3704

500 acid

Pump 80 ft

400-90

RECORD

Cased _____ in., _____ ft.

Sand _____

Gas _____

Oil _____

Total Depth 0282

PRODUCTION

1st 24 hrs. Nat. _____

1st 24 hrs. after shot _____

Gas _____ Cu. Ft.

Dry Hole _____

Abandoned _____

Date

DEC 23 1947 19

S. J. LEWIS Scout