


Section 6 Township 23 Range 9W

Well No. 1 Baldois "B" (Voldois)

Company Cities Service

Peace Creek Pool

NORTH

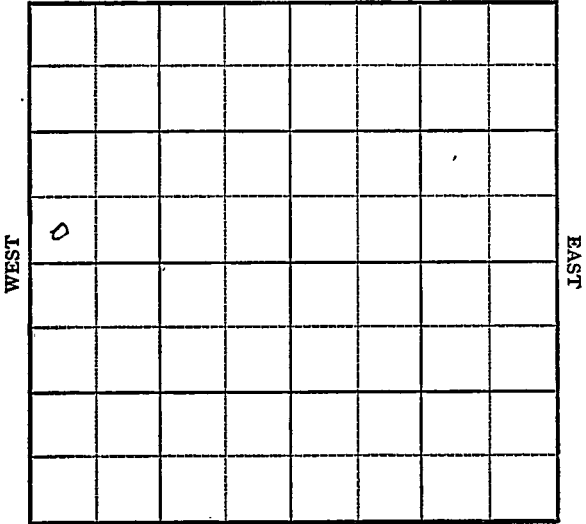

SOUTH

Reno

Sec. 6 **KANSAS** Twp. 23 R. 9W ✓

Well No. #1 Baldois "B" Farm

Cities Service Company


Peace Creek Pool

 Ft. from N. Line

330' Ft. from S. Line

 Ft. from E. Line

330' Ft. from W. Line

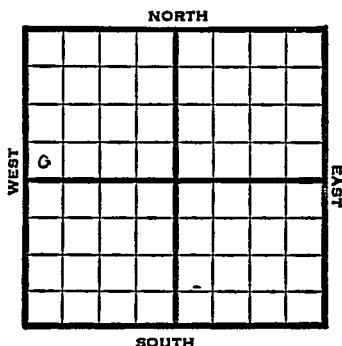

SW NW

1948 Elev. 1743' REPORT

- 12/15 Location
- 12/22 8" @ 260'
Drlg. 1850'
- 12/29 Drlg. 3660'
- 1/5 Meisner 3703'
Viola 3706'
TD 3728'
5" @ 3728'
- 2/12 "
- 1/19 TD 3743 1000 acid
Pump 69 bbls oil / 8W in 24 hrs.
- 1/26 32 shots 3705-11
500 acid
- 2/2 "
- 2/9 "
- 2/16 "
- 2/23 "
- 3/2 "
- 3/8 "
- 3/16 "
- 3/23 "
- 3/30 Viola 3706'
5" @ 3728'
1500 acid
Pump 88 oil & 31W Pot.
Gr. 42°
TD 3743'

COMPLETED

Map No. _____ Sec. 6 Twp. 23 R. 9W

Well No. 1 Baldois "B"

Cities Service Company

FIRST REPORT Contractor

SW NW

SECTION PLAT

_____ Ft. from N. Line

330 Ft. from S. Line

_____ Ft. from E. Line

330 Ft. from W. Line

Reno County

Location X

Rig up _____

Drilling and Remarks:

RECORD

Cased _____ in., _____ ft.

Sand _____

Gas _____

Oil _____

Total Depth _____

PRODUCTION

1st 24 hrs. Nat. _____

1st 24 hrs. after shot _____

Gas _____ Cu. Ft.

Dry Hole _____

Abandoned _____

Date

DEC 15 1948 19

S. J. LEWIS Scout

Kansas

Map No. 41 Sec. 6 Twp. 23 R. 9W

Well No. 1 Baldois "B"

Cities Service Company

COMPLETE

Contractor

SW NW

E 11748
SECTION PLAT

 Ft. from N. Line

330 Ft. from S. Line

 Ft. from E. Line

330 Ft. from W. Line

6			

Reno County

Location

Rig up

Drilling and Remarks:

Vid. 3706
5" C 3728
1500 acid
Pump Soil 731W
B.V.
112 3/4

RECORD

Cased in., ft.

Sand

Gas

Oil

Total Depth 3748

PRODUCTION

1st 24 hrs. Nat.

1st 24 hrs. after shot

Gas Cu. Ft.

Dry Hole

Abandoned

Date

MAR 30 1949 19

S. J. LEWIS Scout