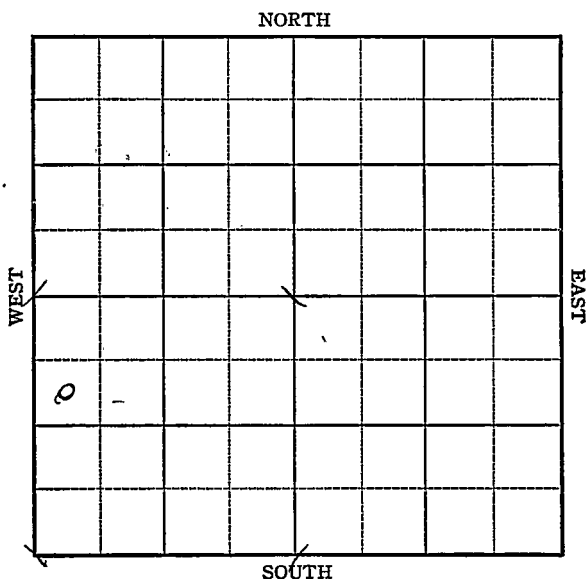


Section 6 Township 23 Range 9-W

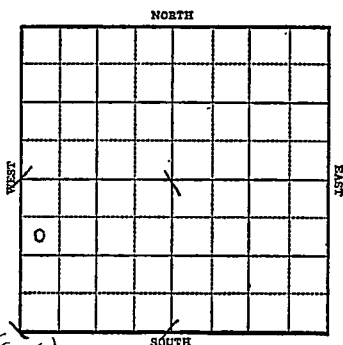
Well No. #1 Morgan

Company Cities Service Oil



Sec. 6 Twp. 23 R. 9-WWell No. #1 Morgan FarmCities Service Oil Company

Peace Creek Pool

990 Ft. from N. Line Ft. from S. Line Ft. from E. Line330 Ft. from W. LineElev. 1743 (Est)

1943

R E P O R T

3/10 Location

3/17 10" Casing set 176' WOC.

3/24 Drlg. 2305'

3/31 Drlg. 3692

4/7 Lans 3222

Kind 3620

Viola 3720

T.D. 3724 sat

7" @ 3708 RUST.

4/14 1800' oil swab 12 oil per hr
2 hrs.

4/21 " " "

4/28 Temp Pot. 90

5/5 T.D. 3742-500 acid

5/12 T.D. 3749

Pump 81 oil on 11 hrs.

5/19 " " " " " "

5/26 Viola 3720

7" @ 3708'

500 gal acid

Pump 90 Pot.

T.D. 3749'

Gravity 42

COMPLETED

Reno

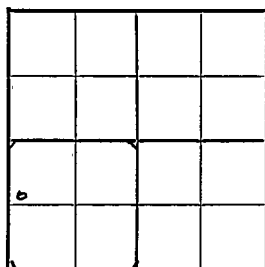
KANSAS

Map No. 41 Sec. 6 Twp. 23 R. 9WWell No. 1 MorganCities Service Oil CompanyFIRST REPORT Contractor

SW NW SW

990 Ft. from N. Line Ft. from S. Line Ft. from E. Line330 Ft. from W. Line

SECTION PLAT

PEACE CREEK POOLLocation XXRig up

Drilling and Remarks:

RECORD

Cased in., ft.Sand Gas Oil Total Depth

PRODUCTION

1st 24 hrs. Nat. 1st 24 hrs. after shot Gas Cu. Ft.Dry Hole Abandoned

Date

MAR 10 1943 19 S. J. LEWIS Scout

Reno

KANSAS

Map No. 4 Sec. 6 Twp. 23 R. 9WWell No. 1 MorganCities Service Oil CompanyCOMPLETED Contractor

SW NW SW

990 Ft. from N. Line Ft. from S. Line Ft. from E. Line330 Ft. from W. Line

SECTION PLAT

PEACE CREEK POOL

Location Rig up

Drilling and Remarks:

*Vista 3720**7" C 3708**500 acid**Pump 90 Pst.**42 c Gr*

RECORD

Cased in., ft.Sand Gas Oil Total Depth 3749

PRODUCTION

1st 24 hrs. Nat. 1st 24 hrs. after shot Gas Cu. Ft.Dry Hole Abandoned

Date

MAY 26 1943 19

S. J. LEWIS Scout